

MARSHALL

J 2026

4-16-77

15E

MISSISSIPPI BOARD OF WATER COMMISSIONERS

416 North State Street
Jackson, Mississippi 39201

WATER WELL DRILLERS LOG

4-16

1977

Earl Jones Well Co.

Marshall

date well completed

firm name

county well located

LANDOWNER:

Charles K. Brewer

Holly Springs Miss. - RT 3
(mailing address)

WELL LOCATION:

sec. 26 T 3 N R 4 E
S W
3 miles S of Red Bank
(distance) (direction) (nearest town)

WELL PURPOSE:

Home (home, irrigation, municipal, industrial)

WELL COMPLETION DATA:

- (1) diameter (inches) 4"
- (2) total depth (feet) 150
- (3) static water level (feet) 100 below top of ground.

(4) casing plastic 140
(material) (depth)

OTK 4" (size) If telescope see back.

(5) screen 10' 140
(length) (depth to top)

0/3- 4" (size) plastic (material)

(6) pump 1/2 1.6
(HP) (yield gpm)

Electric (type power)

(7) electric log no (yes or no)

(organization running log)

(8) how well bottom plugged plastic cap

description of formations encountered

from

to

Topsail	0	4
sand	4	80
clay	80	88
sand	88	120
clay	120	124
sand	124	150

RECEIVED


MAY 10 1977

MISS. BD. OF WATER COMMISSIONERS

DRILLERS REMARKS:

If well telescopes please sketch and show depths.

GROUND LEVEL

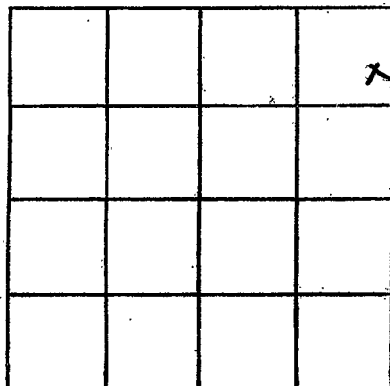

SECTION 26

Please indicate well location X.

ADDITIONAL INFORMATION

If more than one screen, show locations of each on sketch.