

Marshall
J 2027
6-29-77

MISSISSIPPI
 BOARD OF WATER COMMISSIONERS
 416 North State Street
 Jackson, Mississippi 39201

WATER WELL DRILLERS LOG

June 29 1977 Earl Jones Well Co. Marshall
 date well completed firm name county well located

LANDOWNER:
Arthur Turnstall
Red Banks, Miss. Rt. 1
 (mailing address)

WELL LOCATION:
 sec. 10 T. 3 N. R. 4 E.
1/2 miles East of Victoria
 (distance) (direction) (nearest town)

WELL PURPOSE: Home
 (home, irrigation, municipal, industrial)

- WELL COMPLETION DATA:
- (1) diameter (inches) 4"
 - (2) total depth (feet) 155
 - (3) static water level (feet) 95 below/above top of ground.
 - (4) casing plastic (material) 145 (depth)
4" (size) if telescope see back.
 - (5) screen 10' (length) 145 (depth to top)
4"-013 (size) plastic (material)
 - (6) pump 1/2 (HP) 15 (yield gpm)
Electric (type power)
 - (7) electric log no (yes or no)
- (organization running log)
- (8) how well bottom plugged plastic caps

description of formations encountered	from to	
<u>Topsoil & clay</u>	<u>0</u>	<u>10</u>
<u>sand</u>	<u>10</u>	<u>16</u>
<u>clay</u>	<u>16</u>	<u>21</u>
<u>sand</u>	<u>21</u>	<u>40</u>
<u>clay</u>	<u>40</u>	<u>43</u>
<u>sand</u>	<u>43</u>	<u>80</u>
<u>clay</u>	<u>80</u>	<u>84</u>
<u>sand</u>	<u>84</u>	<u>155</u>


RECEIVED
 JUL 5 1977

MISS. Bd. OF WATER COMMISSIONERS

DRILLERS REMARKS:

If well telescopes please sketch and show depths.

GROUND LEVEL

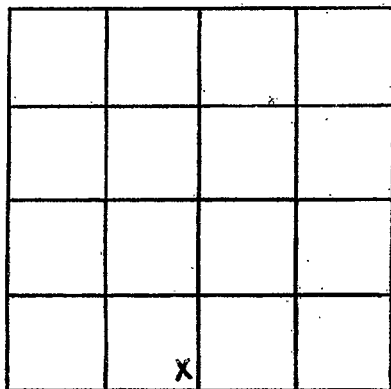

SECTION 10

Please indicate well location X.

ADDITIONAL INFORMATION

If more than one screen, show locations of each on sketch.