

Marshall
 J 2029
 7/15/77

MISSISSIPPI
 BOARD OF WATER COMMISSIONERS
 416 North State Street
 Jackson, Mississippi 39201
 WATER WELL DRILLERS LOG

7-15-1977 (date well completed) Victoria Well Co. Inc. (firm name) Marshall (county well located)

LANDOWNER:
Marye Raymond Vaughn
Victoria
P.O. Box 75 Miss. 38679
 (mailing address)

description of formations encountered	from	to
white clay	0	15
white clay & red sand	15	30
Blue sand	30	105
white sand	105	120
white sand & clay	120	135
white sand	135	205

WELL LOCATION:
 sec. 11 T. 3 N. R. 4 E.
 (distance) miles of (direction) (nearest town)

WELL PURPOSE:
 (home, irrigation, municipal, industrial)

WELL COMPLETION DATA:

(1) diameter (inches) 4

(2) total depth (feet) 205

(3) static water level (feet) 105 below above top of ground.

(4) casing (material) 195 (depth) (size) If telescope see back.

(5) screen (length) 10 (depth to top) (size) gravel packed (material)

(6) pump (HP) (yield gpm) (type power) electric

(7) electric log (yes or no) (organization running log)

(8) how well bottom plugged 4" plastic casing


RECEIVED

DEC 21 1977

DRILLERS REMARKS:

If well telescopes please sketch and show depths.

GROUND LEVEL

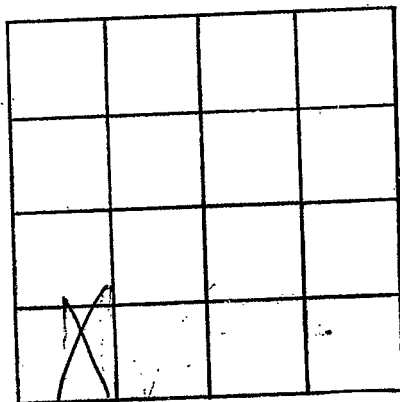

SECTION D

Please indicate well location X.

ADDITIONAL INFORMATION

If more than one screen, show locations of each on sketch.