

Rln 12/12/77

Marshall  
J 2030  
8/21/77

MISSISSIPPI  
BOARD OF WATER COMMISSIONERS  
416 North State Street  
Jackson, Mississippi 39201

WATER WELL DRILLERS LOG

8-27-77 W.A. Mason Marshall  
date well completed firm name county well located

LANDOWNER:		description of formations encountered	from	to
Charles Rockmore				
RFD- Byhalia Miss		Hard Clay	0	16
(mailing address)		Red sand	16	20
		Red clay	20	60
		White sand	60	134
WELL LOCATION:				
sec. <u>25</u> T <u>3</u> N R. <u>4</u> E				
<u>1</u> miles <u>NE</u> of <u>Watson</u>				
(distance) (direction) (nearest town)				
WELL PURPOSE: <u>Home</u>				
(home, irrigation, municipal, industrial)				
WELL COMPLETION DATA:				
(1) diameter (inches) <u>4"</u>				
(2) total depth (feet) <u>134</u>				
(3) static water level (feet) <u>65</u> below top of ground.				
(4) casing <u>Plastic</u> <u>124'</u>				
(material) (depth)				
<u>4"</u> If telescope see back.				
(size)				
(5) screen <u>10'</u> <u>124'</u>				
(length) (depth to top)				
<u>4"</u> <u>Plastic</u>				
(size) (material)				
(6) pump <u>3/4</u> <u>10</u>				
(HP) (yield gpm)				
<u>electric</u>				
(type power)				
(7) electric log <u>No</u>				
(yes or no)				
(organization running log)				
(8) how well bottom plugged <u>Cap</u>				
DRILLERS REMARKS:				


RECEIVED

DEC 12 1977

MISS. BD. OF WATER COMM

If well telescopes please  
sketch and show depths.

GROUND LEVEL

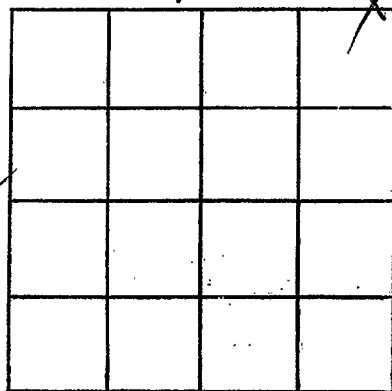

SECTION 25

Please indicate well location X.

ADDITIONAL INFORMATION

If more than one screen,  
show locations of each on sketch.