

Marshall
 J 2031
 9/15/77

MISSISSIPPI
 BOARD OF WATER COMMISSIONERS
 416 North State Street
 Jackson, Mississippi 39201

WATER WELL DRILLERS LOG

9-5-77 date well completed
 W.A. Mason Water Well Center firm name
 Marshall county well located

LANDOWNER:
 Antioch Church
 Victoria Miss-
 (mailing address)

description of formations encountered	from	to
Clay	0	8
Red Sand	8	105
White Sand	105	152

WELL LOCATION:
 sec. 22 T 3 N R 4 E
 3 3/4 miles S E of Victoria
 (distance) (direction) (nearest town)

WELL PURPOSE: Church
 (home, irrigation, municipal, industrial)


- WELL COMPLETION DATA:
- (1) diameter (inches) 4"
 - (2) total depth (feet) 152'
 - (3) static water level (feet) 80' below top of ground
 - (4) casing Plastic, 142'
 (material) (depth)
 4" If telescope see back.
 (size)
 - (5) screen 10' 142'
 (length) (depth to top)
4" Plastic
 (size) (material)
 - (6) pump 3/4 10
 (HP) (yield gpm)
electric
 (type power)
 - (7) electric log NO
 (yes or no)
- (organization running log)
- (8) how well bottom plugged cap

RECEIVED
 DEC 12 1977

DRILLERS REMARKS:

If well telescopes please sketch and show depths.

GROUND LEVEL

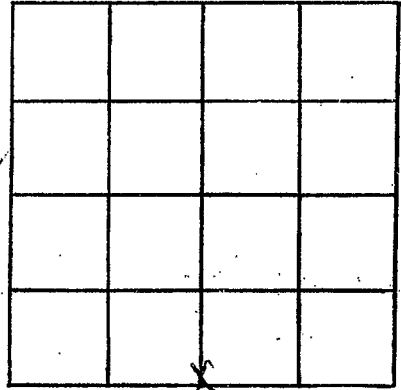

SECTION 22

Please indicate well location X.

ADDITIONAL INFORMATION

If more than one screen, show locations of each on sketch.