

Marshall
 J 2033
 12/2/77

MISSISSIPPI
 BOARD OF WATER COMMISSIONERS
 416 North State Street
 Jackson, Mississippi 39201

WATER WELL DRILLERS LOG

Dec 2 1977 Earl Jones Well Co Marshall
 date well completed firm name county well located

LANDOWNER:
 Lou Ann Schmitz
 Byholio miss. Rt.
 (mailing address)

WELL LOCATION:
 sec 10 T 3 N R 4 E
 3/4 miles S of Victoria
 (distance) (direction) (nearest town)

WELL PURPOSE: Home
 (home, irrigation, municipal, industrial)

WELL COMPLETION DATA:
 (1) diameter (inches) 4"
 (2) total depth (feet) 130
 (3) static water level (feet) 100 below top of ground
 (4) casing plastic 120' (material) (depth)
 4" (size) if telescope see back.
 (5) screen 10' 120' (length) (depth to top)
 4" 013 plastic (size) (material)
 (6) pump 3/4 18 (HP) (yield gpm)
 Electric (type power)
 (7) electric log no (yes or no)
 (organization running log)

(8) how well bottom plugged
 plastic cap

DRILLERS REMARKS:

description of formations encountered	from	to
Topsoil + clay	0	16
sand	16	24
clay	24	32
sand	32	85
clay	85	92
sand	92	130


RECEIVED

DEC 15 1977

MISS. BD. OF WATER COMMISSIONERS

If well telescopes please sketch and show depths.

GROUND LEVEL

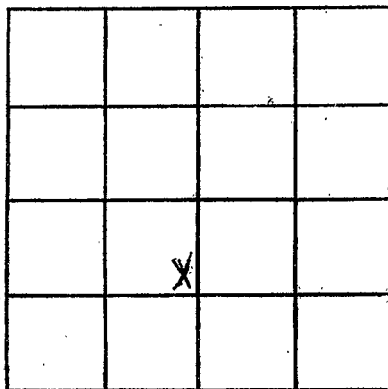

SECTION 10

Please indicate well location X.

ADDITIONAL INFORMATION

If more than one screen, show locations of each on sketch.