

MARSHALL

J 2034

4-21-78

MISSISSIPPI BOARD OF WATER COMMISSIONERS
416 North State Street
Jackson, Mississippi 39201

WATER WELL DRILLERS LOG

4-21 1978
date well completed

Dean & Kent Drilling well
firm name

Marshall
county well located

LANDOWNER:

C. W. MORTON

Red BANKS, Miss.
(mailing address)

description of formations encountered

clay

from

to

0 20

sand

20 190

WELL LOCATION:

sec. 26 T. 3 N. R. 7 E.
(5) (W)

(6) miles S. W. of Red Banks
(distance) (direction) (nearest town)

WELL PURPOSE: Dwelling
(home, irrigation, municipal, industrial)

WELL COMPLETION DATA:

- (1) diameter (inches) 4"
- (2) total depth (feet) 190 feet
- (3) static water level (feet) 115 ft above top of ground.

- (4) casing PVC, 190 feet
(material) (depth)

(size) if telescope see back.

- (5) screen 24", 183 feet
(length) (depth to top)
- 4" gravel wash
(size) (material)

- (6) pump 3/4 HP, 14
(HP) (yield gpm)


(type power)

- (7) electric log yes
(yes or no)

(organization running log)

- (8) how well bottom plugged 4" conf.

DRILLERS REMARKS:

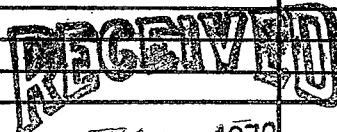


MAY 9 1978

MISS. BD. OF WATER COMM

If well telescopes please sketch and show depths.

GROUND LEVEL

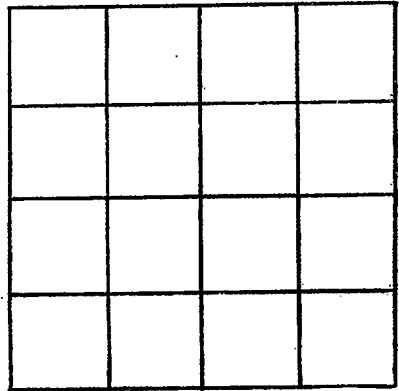

SECTION _____

Please indicate well location X.

ADDITIONAL INFORMATION

If more than one screen, show locations of each on sketch.