

MARSHALL

J 2035

5-11-78

MISSISSIPPI BOARD OF WATER COMMISSIONERS 416 North State Street Jackson, Mississippi 39201

WATER WELL DRILLERS LOG

May 11 1978 Earl Jones Well Co. Marshall date well completed firm name county well located


Table with columns: LANDOWNER, WELL LOCATION, WELL PURPOSE, WELL COMPLETION DATA, description of formations encountered, from, to. Includes handwritten entries for William Watkins, Victoria Miss, and well completion details like diameter (4 inches), total depth (110 feet), and casing material (plastic).

RECEIVED JUN 2 1978

MISS. BD. OF WATER COMMISSIONERS

If well telescopes please sketch and show depths.

GROUND LEVEL

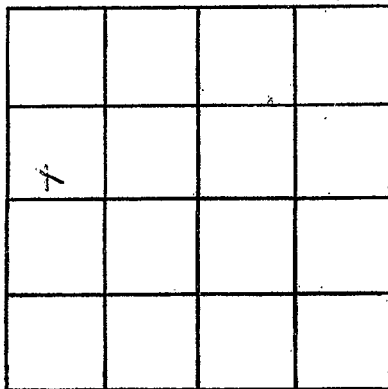

SECTION 10

Please indicate well location X.

ADDITIONAL INFORMATION

If more than one screen, show locations of each on sketch.