

MARSHALL

J 2036

6-1-78

MISSISSIPPI BOARD OF WATER COMMISSIONERS
416 North State Street
Jackson, Mississippi 39201

WATER WELL DRILLERS LOG

June 1 1978 Earl Jones Well Co. Marshall
date well completed firm name county well located

LANDOWNER:

Alton Arnold

Victoria Miss. Bx 166
(mailing address)

WELL LOCATION:

sec. 4 T3 N R 4 E S W

1/2 miles NW of Victoria
(distance) (direction) (nearest town)

WELL PURPOSE: Home
(home, irrigation, municipal, industrial)

WELL COMPLETION DATA:

- (1) diameter (inches) 4"
- (2) total depth (feet) 122
- (3) static water level (feet) 75 below top of ground.
- (4) casing plastic 1 1/2" (material) (depth)
4" (size) if telescope see back.
- (5) screen 10' 1 1/2" (length) (depth to top)
4" - D13 (size) plastic (material)
- (6) pump 1/2 (HP) 16 (yield gpm)
electric (type power)
- (7) electric log no (yes or no)
- (organization running log)

(8) how well bottom-plugged
plastic cap

DRILLERS REMARKS:

description of formations encountered	depth	
	from	to
Topsoil & clay	0	19
sand	19	40
clay	40	44
sand	44	122


RECEIVED

JUN 12 1978

MISS. BD. OF WATER COMM.

If well telescopes please sketch and show depths.

GROUND LEVEL

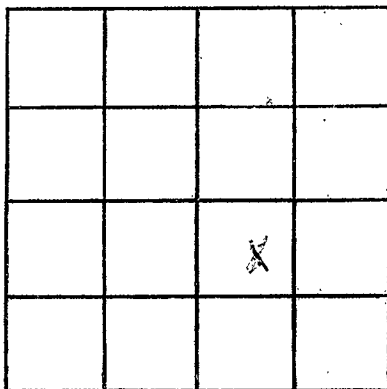

SECTION 4

Please indicate well location X.

ADDITIONAL INFORMATION

If more than one screen,
show locations of each on sketch.