

MARSHALL

J 2038

9-8-78

MISSISSIPPI BOARD OF WATER COMMISSIONERS
416 North State Street
Jackson, Mississippi 39201

WATER WELL DRILLERS LOG

Sept 8
date well completed

1978 Earl Jones Well Co.
firm name

Marshall
county well located

LANDOWNER:

Mrs Lillie Brooks

Victoria Miss.

(mailing address)

WELL LOCATION:

sec 3 T 3 N R 4 E
3/10 miles N of Victoria
(distance) (direction) (nearest town)

WELL PURPOSE: Home
(home, irrigation, municipal, industrial)

WELL COMPLETION DATA:

- (1) diameter (inches) 4"
- (2) total depth (feet) 142
- (3) static water level (feet) 95 below top of ground.
- (4) casing plastic 132 (material) (depth)
4" (size) if telescope see back.
- (5) screen 10 132 (length) (depth to top)
4" - 013 plastic (size) (material)
- (6) pump 1/2 15 (HP) (yield gpm)
electric (type power)
- (7) electric log no (yes or no)

(organization running log)

(8) how well bottom plugged
plastic cap

DRILLERS REMARKS:

description of formations encountered

from to


| | | |
|----------------|----|-----|
| Topsoil & clay | 0 | 16 |
| sand | 16 | 20 |
| clay | 20 | 75 |
| band | 75 | 142 |

RECEIVED
SEP 13 1978

MISS. BD. OF WATER COMMISSIONERS

If well telescopes please sketch and show depths.

GROUND LEVEL

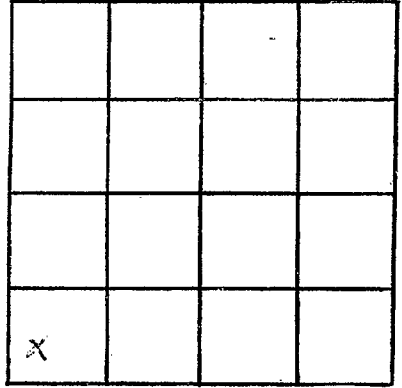

SECTION 3

Please indicate well location X.

ADDITIONAL INFORMATION

If more than one screen,
show locations of each on sketch.