

MARSHALL

J 2039

9-27-78

MISSISSIPPI BOARD OF WATER COMMISSIONERS
416 North State Street
Jackson, Mississippi 39201

WATER WELL DRILLERS LOG

Sept 27

date well completed

1978 Earl Jones Well Co. Marshall

firm name

county well located

LANDOWNER:

George D. Roach

Byhalia Miss. RT
(mailing address)

description of formations encountered

from

to

Topsoil + clay
Sand
Clay
Sand

0 14
14 44
44 47
47 100

WELL LOCATION:

sec 26 T 3 N R 4 E
S W
4 miles S of Victoria
(distance) (direction) (nearest town)

WELL PURPOSE: Home
(home, irrigation, municipal, industrial)


WELL COMPLETION DATA:

- (1) diameter (inches) 4"
- (2) total depth (feet) 100
- (3) static water level (feet) 82 below top of ground.
- (4) casing plastic 90
(material) (depth)
4" if telescope see back.
(size)
- (5) screen 10' 90
(length) (depth to top)
013-4" plastic
(size) (material)
- (6) pump 1/2 16
(HP) (yield gpm)
electric
(type power)
- (7) electric log no
(yes or no)

(organization running log)

(8) how well bottom plugged
plastic cap.


DRILLERS REMARKS:

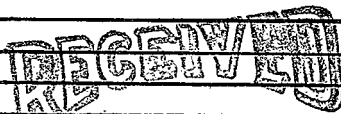

OCT 25 1978

If well telescopes please sketch and show depths.

GROUND LEVEL

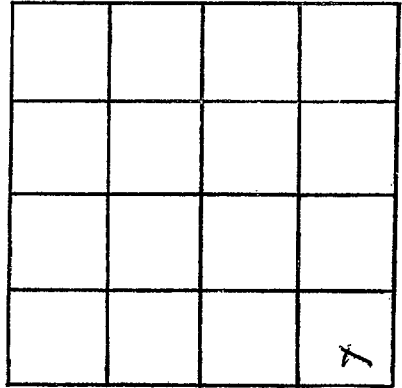

SECTION 26

Please indicate well location X.

ADDITIONAL INFORMATION

If more than one screen,
show locations of each on sketch.