

MARSHALL
J 2040
9-23-78

**MISSISSIPPI
BOARD OF WATER COMMISSIONERS**
416 North State Street
Jackson, Mississippi 39201

WATER WELL DRILLERS LOG

Sept 23 1978 Earl Jones Well Co. Marshall
 date well completed firm name county well located

LANDOWNER:	description of formations encountered	from	to
<u>Jack Burke</u>			
<u>Byhalia Miss. RT.</u> (mailing address)	<u>Topsoil + clay</u>	<u>0</u>	<u>8</u>
	<u>sand</u>	<u>8</u>	<u>15</u>
	<u>clay</u>	<u>15</u>	<u>38</u>
	<u>rocks</u>	<u>38</u>	<u>40</u>
	<u>sand</u>	<u>40</u>	<u>65</u>
	<u>clay</u>	<u>65</u>	<u>69</u>
	<u>sand</u>	<u>69</u>	<u>150</u>
WELL LOCATION:			
sec. <u>16</u> T. <u>3</u> N R. <u>4</u> E			
<u>1 3/4</u> miles <u>SW</u> of <u>Victoria</u>			
(distance) (direction) (nearest town)			
WELL PURPOSE: <u>Home</u> (home, irrigation, municipal, industrial)			
WELL COMPLETION DATA:			
(1) diameter (inches) <u>4"</u>			
(2) total depth (feet) <u>140</u>			
(3) static water level (feet) <u>110</u> below/above top of ground.			
(4) casing <u>plastic</u> <u>130</u> (material) (depth)			
<u>4"</u> if telescope see back. (size)			
(5) screen <u>10'</u> <u>130</u> (length) (depth to top)			
<u>013-4"</u> <u>plastic</u> (size) (material)			
(6) pump <u>1/2</u> <u>15</u> (HP) (yield gpm)			
<u>Electric</u> (type power)			
(7) electric log <u>no</u> (yes or no)			
(organization running log)			
(8) how well bottom plugged <u>plastic cap.</u>			
DRILLERS REMARKS:			


RECEIVED

OCT 25 1978

MISSISSIPPI BOARD OF WATER COMMISSIONERS

If well telescopes please sketch and show depths.

GROUND LEVEL

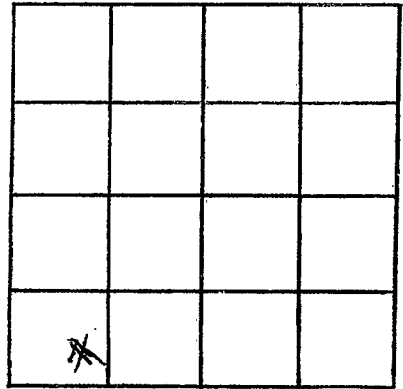

SECTION 16

Please indicate well location X.

ADDITIONAL INFORMATION

If more than one screen,
show locations of each on sketch.