

MARSHALL

J 2041

10-19-78

MISSISSIPPI BOARD OF WATER COMMISSIONERS  
416 North State Street  
Jackson, Mississippi 39201

WATER WELL DRILLERS LOG

OCT 19 1978  
date well completed

Earl Jones Well Co -  
firm name

Marshall  
county well located

LANDOWNER:

James Pondero  
Victoria Miss. Bx 52  
(mailing address)

description of formations encountered

from to

WELL LOCATION:

sect T 3 N R 4 E  
4 S 1 W  
10 miles N. of Victoria  
(distance) (direction) (nearest town)

Topsoil & clay  
sand  
clay  
sand -  
clay  
sand  
clay  
sand  
0 12  
12 16  
16 20  
20 24  
24 28  
28 32  
32 36  
36 40

WELL PURPOSE: Home  
(home, irrigation, municipal, industrial)


WELL COMPLETION DATA:

- (1) diameter (inches) 4"
- (2) total depth (feet) 165'
- (3) static water level (feet) 100 below top of ground.
- (4) casing plastic, 155' (material) (depth)  
4" (size) if telescope see back.
- (5) screen 10' 155' (length) (depth to top)  
013-4" plastic (size) (material)
- (6) pump 1/2 HP 15 (yield gpm)  
electric (type power)
- (7) electric log no (yes or no)

(organization running log)

(8) how well bottom plugged  
P. loose clay


DRILLERS REMARKS:

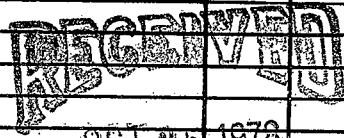

MISS. BD. OF WATER COMM

If well telescopes please sketch and show depths.

GROUND LEVEL

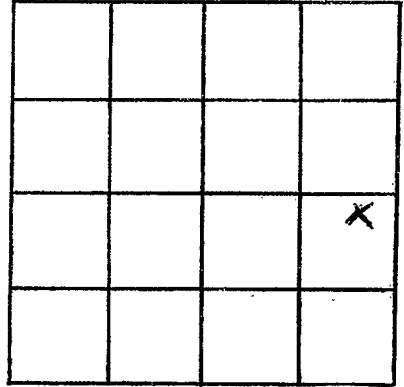

SECTION X

Please indicate well location X.

ADDITIONAL INFORMATION

If more than one screen,  
show locations of each on sketch.