

MARSHALL

J 242

12-18-76

MISSISSIPPI  
BOARD OF WATER COMMISSIONERS  
416 North State Street  
Jackson, Mississippi 39201

WATER WELL DRILLERS LOG

Dec. 18 1976  
date well completed

R L Carpenter  
firm name

Marshall  
county well located

LANDOWNER: Victoria Community Center  
Victoria, Miss.

description of formations encountered	from	to
Surface Soil	0	16
Med white sand	16	60
White & Red Clay	60	88
White coarse sand	88	125

(mailing address)

WELL LOCATION:

sec. 10 T 3 N R 4 E  
S W  
In Victoria, Miss.  
miles of (distance) (direction) (nearest town)

WELL PURPOSE: Community Center  
(home, irrigation, municipal, industrial)

WELL COMPLETION DATA:

- (1) diameter (inches) 4 1/2"
- (2) total depth (feet) 125
- (3) static water level (feet) 58 below above top of ground.
- (4) casing Plastic (material), 119' (depth)  
(size) If telescope see back.
- (5) screen 6' (length), 119' (depth to top)  
4" (size), Plastic & Iron (material)
- (6) pump 1/2 (HP), 8 (yield gpm)  
Elec. (type power)
- (7) electric log No (yes or no)

(organization running log)

(8) how well bottom plugged PVC Cap

DRILLERS REMARKS:


Miss. Board of Water Comm.

MAR 12 1979

RECEIVED

If well telescopes please  
sketch and show depths.

GROUND LEVEL

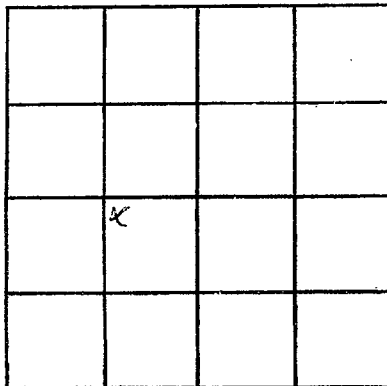

SECTION 10

Please indicate well location X.

ADDITIONAL INFORMATION

If more than one screen,  
show locations of each on sketch.