

MARSHALL
J
03-17-79
<i>2074</i>

**MISSISSIPPI
BOARD OF WATER COMMISSIONERS**
416 North State Street
Jackson, Mississippi 39201

WATER WELL DRILLERS LOG

March 17 19*79* *Earl Jones Well Co* *Marshall*
 date well completed firm name county well located

LANDOWNER:	description of formations encountered	from	to
<i>Andreas Suss</i>			
<i>Red Bank Miss, RT 1.</i> (mailing address)	<i>Topsoil + clay</i>	<i>0</i>	<i>20</i>
	<i>sand</i>	<i>20</i>	<i>36</i>
	<i>Rock</i>	<i>36</i>	<i>38</i>
	<i>sand</i>	<i>38</i>	<i>65</i>
	<i>clay</i>	<i>65</i>	<i>70</i>
	<i>sand</i>	<i>70</i>	<i>92</i>
	<i>rock</i>	<i>92</i>	<i>93</i>
	<i>sand</i>	<i>93</i>	<i>165</i>
WELL LOCATION:			
sec <i>2</i> T <i>3</i> R <i>4</i> S <i>W</i>			
<i>1/4</i> miles <i>E</i> of <i>Victoria</i>			
(distance) (direction) (nearest town)			
WELL PURPOSE: <i>Home</i> (home, irrigation, municipal, industrial)			
WELL COMPLETION DATA:			
(1) diameter (inches) <i>4"</i>			
(2) total depth (feet) <i>165</i>			
(3) static water level (feet) <i>120</i> below top of ground.			
(4) casing <i>plastic</i> <i>155</i> (material) (depth)			
<i>4"</i> (size) If telescope see back.			
(5) screen <i>10'</i> <i>155</i> (length) (depth to top)			
<i>4-D13</i> <i>plastic</i> (size) (material)			
(6) pump <i>1/2</i> <i>14</i> (HP) (yield gpm)			
<i>electric</i> (type power)			
(7) electric log <i>no</i> (yes or no)			
(organization running log)			
(8) how well bottom plugged <i>plastic cap</i>			
DRILLERS REMARKS:			


Miss. Board of Water Comm.

APR 16 1979

RECEIVED

If well telescopes please sketch and show depths.

GROUND LEVEL

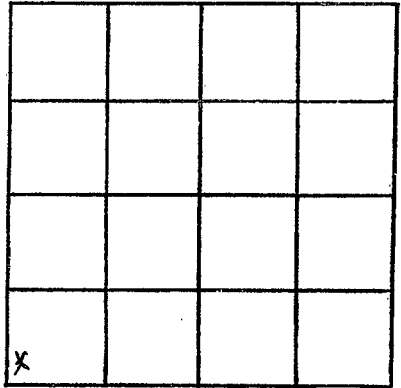

SECTION 2

Please indicate well location X.

ADDITIONAL INFORMATION

If more than one screen, show locations of each on sketch.