

MARSHALL  
J 2047  
4/30/79

MISSISSIPPI  
 BOARD OF WATER COMMISSIONERS  
 416 North State Street  
 Jackson, Mississippi 39201


WATER WELL DRILLERS LOG

April 30 19 79 Earl Jones Well Co Marshall  
 date well completed firm name county well located

LANDOWNER:	description of formations encountered	from	to
<u>Tommy Woods</u>	<u>Topsoil + clay</u>	<u>1-14</u>	
<u>Byholts Miss.</u>	<u>band</u>	<u>14-28</u>	
(mailing address)	<u>clay</u>	<u>28-31</u>	
WELL LOCATION:	<u>sand</u>	<u>31-60</u>	
sec. <u>6</u> T. <u>2</u> N. R. <u>4</u> E. <u>3</u>	<u>clay</u>	<u>60-65</u>	
<u>2</u> miles <u>E</u> of <u>Byholts</u>	<u>sand</u>	<u>65-110</u>	
(distance) (direction) (nearest town)			
WELL PURPOSE: <u>Home</u>			
(home, irrigation, municipal, industrial)			
WELL COMPLETION DATA:			
(1) diameter (inches) <u>4"</u>			
(2) total depth (feet) <u>110</u>			
(3) static water level (feet) <u>50</u> below top of ground.			
(4) casing <u>plastic</u> <u>100</u> (material) (depth)			
<u>4"</u> (size) if telescope see back.			
(5) screen <u>10'</u> <u>100</u> (length) (depth to top)			
<u>0.3-4"</u> (size) <u>plastic</u> (material)			
(6) pump <u>1</u> <u>22</u> (HP) (yield gpm)			
<u>electric</u> (type power)			
(7) electric log <u>no</u> (yes or no)			
(organization running log)			
(8) how well bottom plugged <u>plastic cap</u>			
DRILLERS REMARKS:			

If well telescopes please sketch and show depths.

GROUND LEVEL

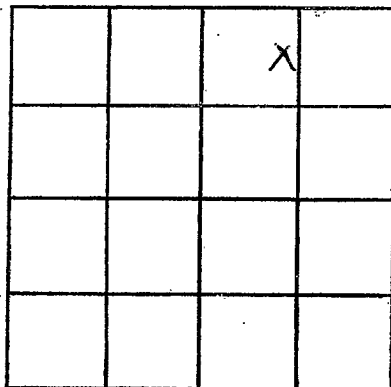

SECTION 6

Please indicate well location X.

ADDITIONAL INFORMATION

If more than one screen,  
show locations of each on sketch.