

MARSHALL

J 2049

7-6-79

MISSISSIPPI BOARD OF WATER COMMISSIONERS
416 North State Street
Jackson, Mississippi 39201

WATER WELL DRILLERS LOG

July 6

1979

Earl Jones Well Co.

Marshall

date well completed

firm name

county well located

LANDOWNER:

O. J. Shinn

description of formations encountered

from

to

Byholio Miss. Rt 1
(mailing address)

Topsoil & clay

0 19

sand

19 25

clay

25 30

sand

30 70

clay

70 78

sand

78 130

WELL LOCATION:

sec. 4 T 3 N R. 4 E
1/2 miles N of Victoria
(distance) (direction) (nearest town)

WELL PURPOSE: Home
(home, irrigation, municipal, industrial)

WELL COMPLETION DATA:

- (1) diameter (inches) 4"
- (2) total depth (feet) 130
- (3) static water level (feet) 75 below top of ground.
- (4) casing plastic 120 (material) (depth)
4" (size) if telescope see back.
- (5) screen 10' 120 (length) (depth to top)
4" - 1/3 (size) plastic (material)
- (6) pump 1/2 16 (HP) (yield gpm)
Electric (type power)
- (7) electric log no (yes or no)

(organization running log)

(8) how well bottom plugged
plastic cap

DRILLERS REMARKS:


Miss. Board of Water Comm.

JUL 30 1979

RECEIVED

If well telescopes please sketch and show depths.

GROUND LEVEL

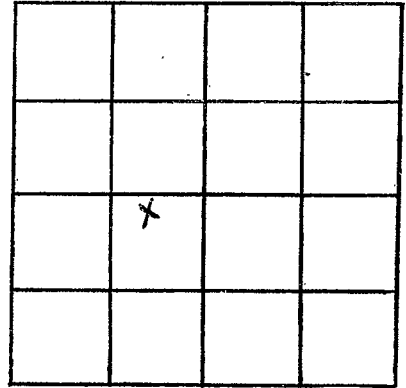

SECTION X

Please indicate well location X.

ADDITIONAL INFORMATION

If more than one screen,
show locations of each on sketch.