

Marshall
J 2050
9-21-79

MISSISSIPPI
BOARD OF WATER COMMISSIONERS
416 North State Street
Jackson, Mississippi 39201

J

WATER WELL DRILLERS LOG

Sept 21 1979
date well completed

Earl Jones Well Co
firm name

Marshall
county well located

LANDOWNER:	description of formations encountered	from	to
Chuck Mc Clatchey Red Banks Miss - (mailing address)			
WELL LOCATION: sec 2 T 3 N R 42 E S 3/4 miles W of Red Banks (distance) (direction) (nearest town)			
WELL PURPOSE: Home (home, irrigation, municipal, industrial)			
WELL COMPLETION DATA:			
(1) diameter (inches) 4"			
(2) total depth (feet) 185			
(3) static water level (feet) 110 below top of ground.			
(4) casing plastic 175 (material) (depth)			
4" (size) if telescope see back.			
(5) screen 10' 175 (length) (depth to top)			
.013-4" plastic (size) (material)			
(6) pump 1 20 (HP) (yield gpm)			
electric (type power)			
(7) electric log no (yes or no)			
(organization running log)			
(8) how well bottom plugged plastic cap			
DRILLERS REMARKS:			


DEPT. OF NATURAL RESOURCES
BUREAU OF LAND & WATER RESOURCES

OCT 5 1979

RECEIVED

If well telescopes please sketch and show depths.

GROUND LEVEL

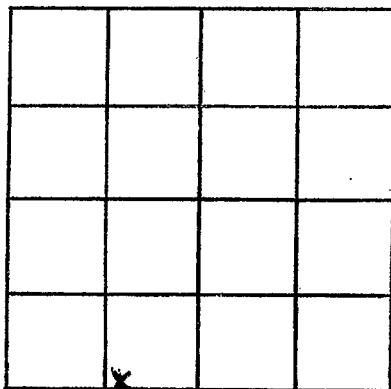

SECTION 12

Please indicate well location X.

ADDITIONAL INFORMATION

If more than one screen,
show locations of each on sketch.