

Marshall
J 2051
9/11/79

MISSISSIPPI
BOARD OF WATER COMMISSIONERS
416 North State Street
Jackson, Mississippi 39201

WATER WELL DRILLERS LOG

Sept 14 1979 Earl Jones Well Co Marshall
date well completed firm name county well located

LANDOWNER: Al Moulton
~~John Moulton~~ Byhalia Miss
P.O. 3
(mailing address)

WELL LOCATION:
sec. 10 (3) T₈ R₇ E₁ W
3/4 miles SE of Vicksburg
(distance) (direction) (nearest town)

WELL PURPOSE: Home
(home, irrigation, municipal, industrial)

WELL COMPLETION DATA:
(1) diameter (inches) 4"
(2) total depth (feet) 135
(3) static water level (feet) 90 below top of ground.
(4) casing plastic (material), 125 (depth), 4" (size) if telescope see back.
(5) screen 10' (length), 125 (depth to top), 0.13-4" (size), plastic (material).
(6) pump 3/4 (HP), 18 (yield gpm), electric (type power)
(7) electric log no (yes or no)
(organization running log)

(8) how well bottom plugged plastic cap

DRILLERS REMARKS:

description of formations encountered	from	to
Topsail + clay	0	14
sand	14	25
clay	25	40
sand	40	50
strata of clay + sand	50	70
sand	70	90
clay	90	95
sand	95	125


DEPT. OF NATURAL RESOURCES
BUREAU OF LAND & WATER RESOURCES

OCT 5 1979

RECEIVED

If well telescopes please sketch and show depths.

GROUND LEVEL

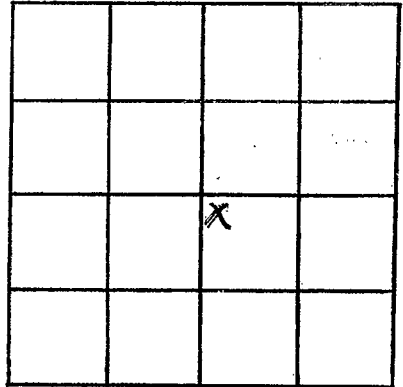

SECTION 10

Please indicate well location X.

ADDITIONAL INFORMATION

If more than one screen,
show locations of each on sketch.