

Marshall
J 2054

MISSISSIPPI
BOARD OF WATER COMMISSIONERS
416 North State Street
Jackson, Mississippi 39201

Pln Dec 10-79
for W.L.
JR

11-19-79

WATER WELL DRILLERS LOG

11-19 19 79
date well completed

Nicho Wells Co
firm name

Marshall
county well located

LANDOWNER:
Loam Owens
Victoria Miss
(mailing address)

description of formations encountered	from	to
	Clay	0
red sand	25	90
white sand	90	125

WELL LOCATION:
sec. 4 T-3 N R-4 E
2 miles N of Victoria
(distance) (direction) (nearest town)

WELL PURPOSE: home
(home, irrigation, municipal, industrial)

WELL COMPLETION DATA:

(1) diameter (inches) 4 in

(2) total depth (feet) 125

(3) static water level (feet) 80 below top of ground

(4) casing Plastic 125 (material) (depth)

(size) if telescope see back.

(5) screen 7 ft, 118 (length) (depth to top)
4 in, Ironnel (size) (material)

(6) pump 1/2 10 (HP) (yield gpm)
200 (type power)

(7) electric log ON (yes or no)

(organization running log)

(8) how well bottom plugged Cap

DRILLERS REMARKS:


DEPT. OF NATURAL RESOURCES
BUREAU OF LAND & WATER RESOURCES

DEC 10 1979

RECEIVED

If well telescopes please
sketch and show depths.

GROUND LEVEL

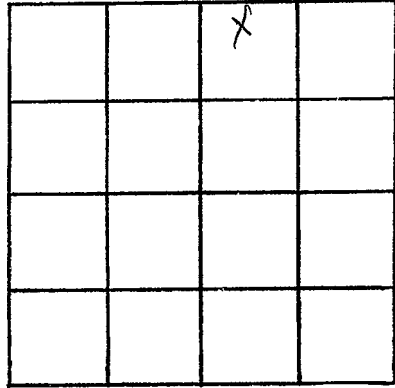

SECTION 3

Please indicate well location X.

ADDITIONAL INFORMATION

If more than one screen,
show locations of each on sketch.