

Marshall

MISSISSIPPI
BOARD OF WATER COMMISSIONERS
416 North State Street
Jackson, Mississippi 39201

JT 2055

5-8-80
5-8

WATER WELL DRILLERS LOG

1980 Hicks Wells Marshall
date well completed firm name county well located

LANDOWNER:
Ordy Benchohona
Kelly Springs
(mailing address)

description of formations encountered	from	to
clay	0	40
red sand	40	90
white sand	90	155

WELL LOCATION:
sec. 27 T. 3 N R. 4 E
3 1/2 miles S of Vestal
(distance) (direction) (nearest town)

WELL PURPOSE: home
(home, irrigation, municipal, industrial)

- WELL COMPLETION DATA:
- (1) diameter (inches) 4 in
 - (2) total depth (feet) 155
 - (3) static water level (feet) 90 below top of ground.
 - (4) casing ~~Aluminum~~ 155
(material) (depth)
 - (size) if telescope see back.
 - (5) screen 7 ft 148
(length) (depth to top)
 - 4 in Gravel
(size) (material)
 - (6) pump 1 1/2 18
(HP) (yield gpm)
 - 220
(type power)
 - (7) electric log No
(yes or no)
 - (organization running log)
 - (8) how well bottom plugged Cap

DRILLERS REMARKS:


DEPT. OF NATURAL RESOURCES
BUREAU OF LAND & WATER RESOURCES

JUN 25 1980

RECEIVED

If well telescopes please sketch and show depths.

GROUND LEVEL

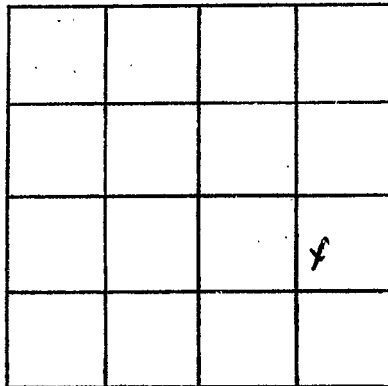

SECTION 27

Please indicate well location X.

ADDITIONAL INFORMATION

If more than one screen,
show locations of each on sketch.