

Marshall  
JT 2056  
5-27-80

MISSISSIPPI  
 BOARD OF WATER COMMISSIONERS  
 416 North State Street  
 Jackson, Mississippi 39201

WATER WELL DRILLERS LOG

5-27 1980 Dent Water Works Co. Marshall  
 date well completed firm name county well located

LANDOWNER:  
Louise Wilson  
Red Banks, Miss  
 (mailing address)

description of formations encountered	from	to
<u>Clay</u>	<u>0</u>	<u>10</u>
<u>Sand</u>	<u>10</u>	<u>160</u>

WELL LOCATION:  
 sec. 24 T 3 N R. 4 E  
4 miles South of Red Bank  
 (distance) (direction) (nearest town)

WELL PURPOSE: Drinking  
 (home, irrigation, municipal, industrial)

- WELL COMPLETION DATA:
- (1) diameter (inches) 4"
  - (2) total depth (feet) 160 feet
  - (3) static water level (feet) 80 below top of ground.
  - (4) casing PVC 160 feet  
 (material) (depth)
  - (size) If telescope see back.
  - (5) screen 24" 153 feet  
 (length) (depth to top)
  - 4" Gravel  
 (size) (material)
  - (6) pump 3/4 14  
 (HP) (yield gpm)
  - (type power)
  - (7) electric log Elect.  
 (yes or no)
  - (organization running log)
  - (8) how well bottom plugged 4" cap

DEPT. OF NATURAL RESOURCES  
 BUREAU OF LAND & WATER RESOURCES


JUN 18 1980

RECEIVED

DRILLERS REMARKS:

If well telescopes please  
sketch and show depths.

GROUND LEVEL

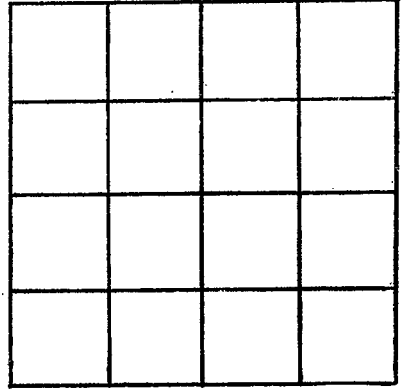

SECTION \_\_\_\_\_

Please indicate well location X.

ADDITIONAL INFORMATION

If more than one screen,  
show locations of each on sketch.