

Marshall

J 2057

6-16-80

June 16 - 1980  
date well completed

MISSISSIPPI  
BOARD OF WATER COMMISSIONERS  
416 North State Street  
Jackson, Mississippi 39201

WATER WELL DRILLERS LOG

Earl Jones Well Co  
firm name

Marshall  
county well located

LANDOWNER:	description of formations encountered	from	to
<u>Peter F Jones</u>			
<u>Holly Springs - Miss RT-3</u> (mailing address)	<u>Top soil &amp; clay</u>	<u>0</u>	<u>19</u>
	<u>sand</u>	<u>19</u>	<u>35</u>
	<u>clay</u>	<u>35</u>	<u>39</u>
	<u>sand</u>	<u>39</u>	<u>110</u>
	<u>clay</u>	<u>110</u>	<u>115</u>
	<u>sand</u>	<u>115</u>	<u>140</u>
WELL LOCATION: sec. <u>14</u> T. <u>3</u> N R. <u>4</u> E <u>2</u> miles SW. of <u>Red Bank</u> (distance) (direction) (nearest town)			
WELL PURPOSE: <u>Home</u> (home, irrigation, municipal, industrial)			
WELL COMPLETION DATA:			
(1) diameter (inches) <u>4</u>			
(2) total depth (feet) <u>140</u>			
(3) static water level (feet) <u>12</u> below top of ground			
(4) casing <u>plastic</u> <u>130'</u> (material) (depth) <u>4'</u> if telescope see back. (size)			
(5) screen <u>10'</u> <u>130</u> (length) (depth to top) <u>013</u> <u>plastic</u> (size) (material)			
(6) pump <u>1/2</u> <u>12</u> (HP) (yield gpm) <u>electric</u> (type power)			
(7) electric log <u>no</u> (yes or no)			
(organization running log)			
(8) how well bottom plugged <u>plastic cap</u>			
DRILLERS REMARKS:			


DEPT. OF NATURAL RESOURCES  
BUREAU OF LAND & WATER RESOURCES

JUL 23 1980

RECEIVED

If well telescopes please sketch and show depths.

GROUND LEVEL

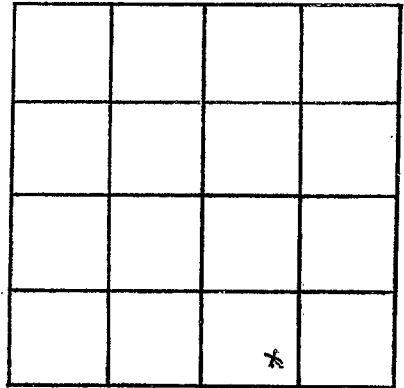

SECTION 14

Please indicate well location X.

ADDITIONAL INFORMATION

If more than one screen,  
show locations of each on sketch.