

MARSHALL
J 2058
7-24-80

MISSISSIPPI
 BOARD OF WATER COMMISSIONERS
 416 North State Street
 Jackson, Mississippi 39201

WATER WELL DRILLERS LOG

7/24/80 date well completed 1980 B. Smith & Howell Ser. firm name Marshall county well located

LANDOWNER:
Maude Cummings
Victoria, Miss.
 (mailing address)

description of formations encountered	from	to
<u>Top Soil</u>	<u>0</u>	<u>5</u>
<u>red clay</u>	<u>5</u>	<u>60</u>
<u>red sand</u>	<u>60</u>	<u>80</u>
<u>white sand</u>	<u>80</u>	<u>210</u>

WELL LOCATION:
 sec 10 T 3 N R 4 E
3/4 miles S.E. of Victoria
 (distance) (direction) (nearest town)

WELL PURPOSE:
 (home) irrigation; municipal, industrial

- WELL COMPLETION DATA:
- (1) diameter (inches) 4"
 - (2) total depth (feet) 210'
 - (3) static water level (feet) 130' below above top of ground.
 - (4) casing plastic, 210'
 (material) (depth)
 _____ if telescope see back.
 (size)
 - (5) screen 20', 210'
 (length) (depth to top)
4", plastic
 (size) (material)
 - (6) pump 1/2, 10
 (HP) (yield gpm)
elec.
 (type power)
 - (7) electric log (yes or no)

 (organization running log)
 - (8) how well bottom plugged cap

DEPT. OF NATURAL RESOURCES
 BUREAU OF LAND & WATER RESOURCES


OCT 15 1980

RECEIVED

DRILLERS REMARKS:

If well telescopes please sketch and show depths.

GROUND LEVEL

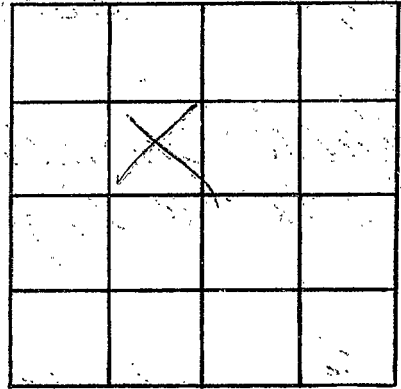

SECTION _____

Please indicate well location X.

ADDITIONAL INFORMATION

If more than one screen, show locations of each on sketch.