

**MISSISSIPPI DEPARTMENT OF NATURAL RESOURCES**  
 Bureau of Land and Water Resources  
 Southport Mall  
 P.O. Box 10631  
 Jackson, Mississippi 39209  
**WATER WELL DRILLERS LOG**

**MARSHALL**  
**J 2059**  
**9-10-80**

2

9-10-1980 date well completed  
 Demuffert Pumpwell firm name  
 Marshall county well located

LANDOWNER:	description of fomations encountered	from	to
Loran Weeks	Clay	0	20
R of Bonpe, Miss. (mailing address)	Sand	20	170
<b>WELL LOCATION:</b>			
sec. <u>25</u> T <u>3</u> N R <u>4</u> E (distance) <u>7</u> miles <u>West</u> of <u>Halls</u> (direction) (nearest town)			
<b>WELL PURPOSE:</b> <u>Drinking</u> (home, irrigation, municipal, industrial)			
<b>WELL COMPLETION DATA:</b>			
(1) diameter (inches) <u>4"</u>			
(2) total depth (feet) <u>170 feet</u>			
(3) static water level (feet) <u>104</u> below above top of ground.			
(4) casing <u>PVC</u> (material), _____ (depth), _____ (size) if telescope see back.			
(5) screen <u>2 ft.</u> (length), <u>20</u> (depth to top)			
<u>1/2"</u> (size), <u>gravel</u> (material)			
(6) pump <u>3/4</u> (HP), <u>14</u> (yield gpm)			
(type power)			
(7) electric log <u>Close</u> (yes or no)			
(organization running log)			
(8) how well bottom plugged <u>4' cof.</u>			
DRILLERS REMARKS:			


DEPT. OF NATURAL RESOURCES  
 BUREAU OF LAND & WATER RESOURCES

OCT - 8 1980

**RECEIVED**

If well telescopes please  
sketch and show depths.

GROUND LEVEL

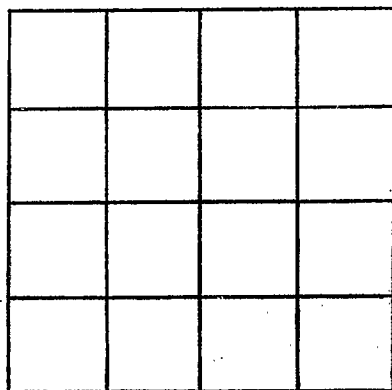

SECTION \_\_\_\_\_

Please indicate well location X.

ADDITIONAL INFORMATION

If more than one screen,  
show locations of each on sketch.