

3

MARSHALL
J 2060
10-31-80

MISSISSIPPI
BOARD OF WATER COMMISSIONERS
416 North State Street
Jackson, Mississippi 39201

WATER WELL DRILLERS LOG

Oct 31 1980 Earl Jones Well Co Marshall
date well completed firm name county well located


LANDOWNER: <u>James Watkins</u> <u>Victoria Miss.</u>	description of formations encountered		from	to
(mailing address)	<u>Topsoil & clay</u>		<u>0</u>	<u>16</u>
	<u>Sand</u>		<u>16</u>	<u>20</u>
	<u>clay</u>		<u>20</u>	<u>63</u>
	<u>sand</u>		<u>63</u>	<u>90</u>
	<u>clay</u>		<u>90</u>	<u>98</u>
	<u>sand</u>		<u>98</u>	<u>145</u>
WELL LOCATION: sec. <u>17</u> T <u>3</u> N R <u>X</u> E <u>1 1/2</u> miles S W. of <u>Victoria</u> (distance) (direction) (nearest town)				
WELL PURPOSE: <u>Home</u> (home, irrigation, municipal, industrial)				
WELL COMPLETION DATA:				
(1) diameter (inches) <u>4"</u>				
(2) total depth (feet) <u>145</u>				
(3) static water level (feet) <u>125</u> below top of ground.				
(4) casing <u>plastic</u> <u>135</u> (material) (depth) <u>4"</u> (size) if telescope see back.				
(5) screen <u>10'</u> <u>135</u> (length) (depth to top)				
<u>0 1/3 - 4'</u> <u>plastic</u> (size) (material)				
(6) pump <u>1/2</u> <u>14</u> (HP) (yield gpm) <u>electric</u> (type power)				
(7) electric log <u>no</u> (yes or no)				
(organization running log)				
(8) how well bottom plugged <u>plastic caps</u>				
DRILLERS REMARKS:				

DEPT. OF NATURAL RESOURCES
BUREAU OF LAND & WATER RESOURCES

NOV 13 1980
RECEIVED

If well telescopes please
sketch and show depths.

GROUND LEVEL

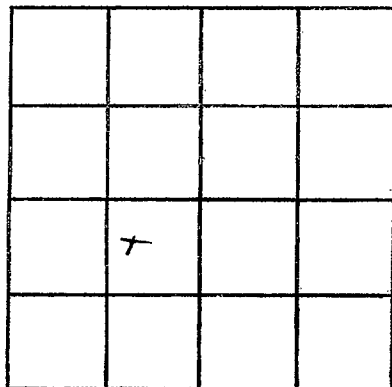

SECTION 17

Please indicate well location X.

ADDITIONAL INFORMATION

If more than one screen,
show locations of each on sketch.