

MARSHALL
J 2061
10-9-80

MISSISSIPPI
BOARD OF WATER COMMISSIONERS
 416 North State Street
 Jackson, Mississippi 39201

WATER WELL DRILLERS LOG

Oct 9 1980 Earl Jones Well Co Marshall
 date well completed firm name county well located

LANDOWNER: C.B. Traylor
Byholio Miss. RT2

description of formations encountered	from	to
<u>Topsoil & clay</u>	<u>0</u>	<u>16</u>
<u>sands</u>	<u>16</u>	<u>22</u>
<u>clay</u>	<u>22</u>	<u>34</u>
<u>sand</u>	<u>34</u>	<u>80</u>
<u>clay</u>	<u>80</u>	<u>85</u>
<u>sand</u>	<u>85</u>	<u>132</u>

(mailing address)

WELL LOCATION:

sec 2 T 3 N R X E S W
3 1/2 miles W of Victoria
 (distance) (direction) (nearest town)

WELL PURPOSE: Home
 (home, irrigation, municipal, industrial)

WELL COMPLETION DATA:

- (1) diameter (inches) 4"
- (2) total depth (feet) 132
- (3) static water level (feet) 83 below/above top of ground.
- (4) casing plastic 122
 (material) (depth)
4" if telescope see back.
 (size)
- (5) screen 10' 122
 (length) (depth to top)
0.13-4" plastic
 (size) (material)
- (6) pump 1/2 15
 (HP) (yield gpm)
electric
 (type power)
- (7) electric log no
 (yes or no)

(organization running log)

(8) how well bottom plugged plastic cap


DRILLERS REMARKS:

DEPT. OF NATURAL RESOURCES
 BUREAU OF LAND & WATER RESOURCES

NOV 13 1980
RECEIVED

If well telescopes please sketch and show depths.

GROUND LEVEL

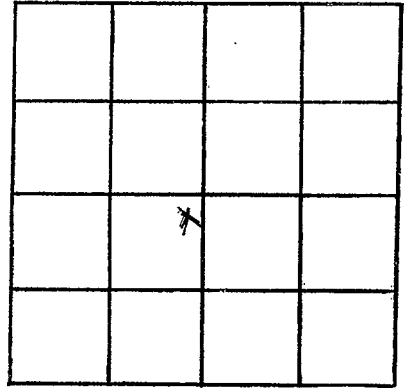

SECTION 2

Please indicate well location X.

ADDITIONAL INFORMATION

If more than one screen,
show locations of each on sketch.