

Marshall
J 2062
11-12-80

MISSISSIPPI
BOARD OF WATER COMMISSIONERS
416 North State Street
Jackson, Mississippi 39201

WATER WELL DRILLERS LOG

11-12-1980 ~~Robert~~ Robert Marshall
date well completed firm name county well located

LANDOWNER:
Mae Della Muckler
Holly Springs, Miss
(mailing address)

WELL LOCATION:
sec. 24 T-3 N R-4 E
5 miles W of Holly Springs
(distance) (direction) (nearest town)

WELL PURPOSE: Home
(home, irrigation, municipal, industrial)

WELL COMPLETION DATA:
(1) diameter (inches) 4
(2) total depth (feet) 233
(3) static water level (feet) _____ below above top of ground.
(4) casing Plastic, 223
(material) (depth)
4" if telescope see back.
(size)
(5) screen 10, 213
(length) (depth to top)
4, gravel pack
(size) (material)
(6) pump 3/4, 12
(HP) (yield gpm)
electric
(type power)
(7) electric log No
(yes or no)
(organization running log)
(8) how well bottom plugged 4"
plastic cap

description of formations encountered	from	to
Red clay + Red Sand	0	30
white clay Rock	30	60
white clay	60	90
Red Sand	90	105
Red Sand white clay	105	130
white clay + Red Sand	130	135
Red Sand	135	175
white Sand	175	210
Brown Sand	210	233

DEPT. OF NATURAL RESOURCES
BUREAU OF LAND & WATER RESOURCES


DEC 18 1980

RECEIVED

DRILLERS REMARKS:

If well telescopes please sketch and show depths.

GROUND LEVEL

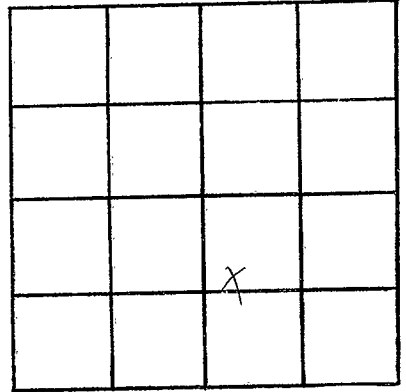

SECTION 29

Please indicate well location X.

ADDITIONAL INFORMATION

If more than one screen,
show locations of each on sketch.