

MISSISSIPPI DEPARTMENT OF NATURAL RESOURCES

Bureau of Land and Water Resources

Southport Mall

P.O. Box 10631

Jackson, Mississippi 39209

WATER WELL DRILLERS LOG

Marshall
J 2063
2-28-81
2-28 1981

Hicks Well Co. Marshall

date well completed

firm name

county well located

LANDOWNER: Ralph Woods

description of formations encountered

from

to

Oliver Branch, Ms.
(mailing address)

Red Sand 0 10

White Sand 10 155

WELL LOCATION:

sec. 7 T 3 N R 4 E
1 miles E of Wesson
(distance) (direction) (nearest town)

White Sand + Clay 155 170

WELL PURPOSE: Subsidence
(home, irrigation, municipal, industrial)

WELL COMPLETION DATA:

(1) diameter (inches) 4

(2) total depth (feet) 170

(3) static water level (feet) 150 below top of ground.

(4) casing PVC 170
(material) (depth)

 if telescope see back.
(size)

(5) screen 12 130
(length) (depth to top)

4" gravel type
(size) (material)

(6) pump 2 22
(HP) (yield gpm)

220V
(type power)

(7) electric log No
(yes or no)

(organization running log)

(8) how well bottom plugged Cap

DRILLERS REMARKS:


DEPT. OF NATURAL RESOURCES
BUREAU OF LAND & WATER RESOURCES

MAR 18 1981

RECEIVED

If well telescopes please sketch and show depths.

GROUND LEVEL

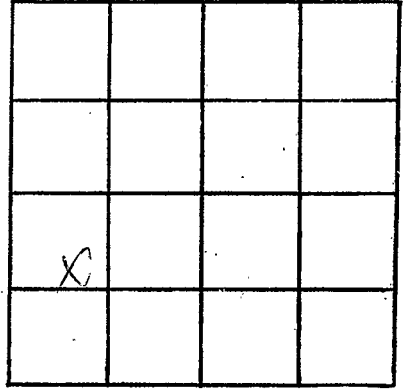

SECTION 7

Please indicate well location X.

ADDITIONAL INFORMATION

If more than one screen,
show locations of each on sketch.