

MARSHALL
 J 2065
 4/5/81
 4-05

MISSISSIPPI
 BOARD OF WATER COMMISSIONERS
 416 North State Street.
 Jackson, Mississippi 39201

WATER WELL DRILLERS LOG

Frost Well Supply Marshall
 date well completed firm name county well located

LANDOWNER: Ben Eastberry
 Castleberry
 Red Banks, Miss.

description of formations encountered	from	to
clay	0	25
sand	25	110
clay	110	129
sand	129	170

(mailing address)

WELL LOCATION:
 sec. 2-T-3 N R-4 E
2 miles W of Red Banks
 (distance) (direction) (nearest town)

WELL PURPOSE:
 (home, irrigation, municipal, industrial)

- WELL COMPLETION DATA:
- diameter (inches) 4"
 - total depth (feet) 170
 - static water level (feet) 120 below above top of ground.
 - casing PVC (material), (depth) 4" (size) if telescope see back.
 - screen 10' (length), (depth to top) 4" (size), (material)
 - pump 3/4 (HP), 10 (yield gpm)
Elc. (type power)
 - electric log NO (yes or no)
 (organization running log)
 - how well bottom plugged Cap.

DRILLERS REMARKS:


DEPT. OF NATURAL RESOURCES
 BUREAU OF LAND & WATER RESOURCES

MAY 18 1981

RECEIVED

If well telescopes please sketch and show depths.

GROUND LEVEL

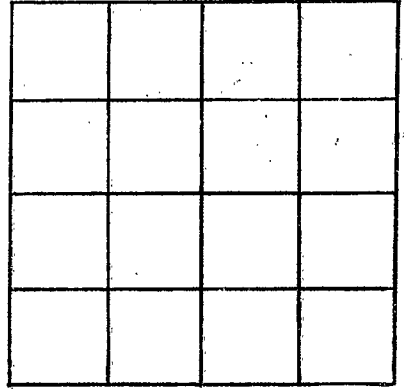

SECTION _____

Please indicate well location X.

ADDITIONAL INFORMATION

If more than one screen, show locations of each on sketch.