

Marshall
 J 2066
 4/19/81
 4-19 1981

MISSISSIPPI
 BOARD OF WATER COMMISSIONERS
 416 North State Street
 Jackson, Mississippi 39201

WATER WELL DRILLERS LOG

Frost Well Supply Marshall
 firm name county well located

LANDOWNER: Charles Waddell

Route 1 Box 48A
 Red Bank, Miss.
 (mailing address)

WELL LOCATION:

sec. 2 T 3 N R 4 E
 2 miles W of Red Bank
 (distance) (direction) (nearest town)

WELL PURPOSE:

(home, irrigation, municipal, industrial)

WELL COMPLETION DATA:

- (1) diameter (inches) 4"
- (2) total depth (feet) 150
- (3) static water level (feet) 100 below top of ground.
- (4) casing PVC (material), (depth) 4" (size) if telescope see back.
- (5) screen 10 (length), (depth to top) 4" (size) (material)
- (6) pump 3/4 (HP), (yield gpm) Elec. (type power)
- (7) electric log ND (yes or no)
- (organization running log)
- (8) how well bottom plugged Cap.

description of formations encountered

from

to


clay	0	10
sand	10	60
clay	60	85
sand	85	150

DRILLERS REMARKS:

MAY 18 1981
 RECEIVED
 NATURAL RESOURCES
 LAND & WATER RESOURCES

If well telescopes please
sketch and show depths.

GROUND LEVEL

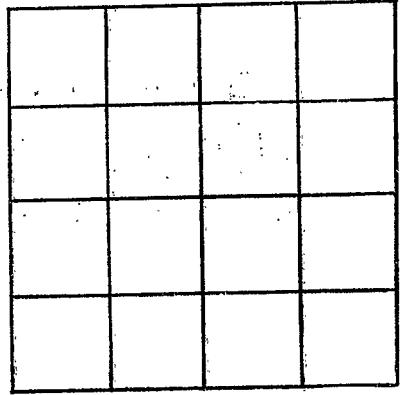

SECTION _____

Please indicate well location X.

ADDITIONAL INFORMATION

If more than one screen,
show locations of each on sketch.