

Marshall
J 2009

MISSISSIPPI
BOARD OF WATER COMMISSIONERS
416 North State Street
Jackson, Mississippi 39201

WATER WELL DRILLERS LOG

April 21 1982 Earl Jones Well Co. Marshall
date well completed firm name county well located


LANDOWNER:	description of formations encountered	from	to
Taylor Chapel Church Victoria, Miss. (mailing address)			
WELL LOCATION: sec. 10 T 3 N R 4 E S W 1/4 miles of Victoria (distance) (direction) (nearest town)			
WELL PURPOSE: church (home, irrigation, municipal, industrial)			
WELL COMPLETION DATA:			
(1) diameter (inches) 4"			
(2) total depth (feet) 200			
(3) static water level (feet) 75 below top of ground.			
(4) casing Plastic 200' (material) (depth) 4" (size) if telescope see back.			
(5) screen 10' 190 (length) (depth to top) 4" 013 plastic (size) (material)			
(6) pump 1/2 14 (HP) (yield gpm) electric (type power)			
(7) electric log no (yes or no)			
(organization running log)			
(8) how well bottom plugged plastic cap.			
DRILLERS REMARKS:			

DEPT. OF NATURAL RESOURCES
BUREAU OF LAND & WATER RESOURCES

MAY 18 1982
RECEIVED

If well telescopes please sketch and show depths.

GROUND LEVEL

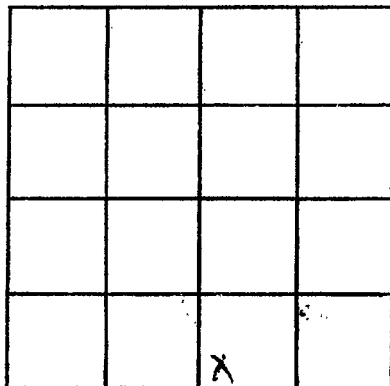

SECTION 10

Please indicate well location X.

ADDITIONAL INFORMATION

If more than one screen,
show locations of each on sketch.