

MISSISSIPPI DEPARTMENT OF NATURAL RESOURCES
Bureau of Land and Water Resources
 Southport Mall
 P.O. Box 10631
 Jackson, Mississippi 39209
WATER WELL DRILLERS LOG

<i>Marshall</i>
<i>J</i>
<i>2071</i>

5-5 19*82* *Marshall* *Marshall*
 date well completed firm name county well located

LANDOWNER: *Chasley Holland*

P.O. Box 128

Byhalia, Miss 38611
 (mailing address)

WELL LOCATION:

sec. *18* T. *3* N. R. *4* E.
1 1/2 miles *East* of *Warsaw*
 (distance) (direction) (nearest town)

WELL PURPOSE:

(home) irrigation, municipal, industrial

WELL COMPLETION DATA:

- (1) diameter (inches) *4"*
- (2) total depth (feet) *154*
- (3) static water level (feet) *20* below above top of ground.
- (4) casing *Plastic*, *144*
 (material) (depth)
4" if telescope see back.
 (size)
- (5) screen *10'*, *144*
 (length) (depth to top)
4, *Plastic Sotted*
 (size) (material)
- (6) pump *3/4*, *10*
 (HP) (yield gpm)
Electric
 (type power)
- (7) electric log *(yes or no)*
 (organization running log)
- (8) how well bottom plugged *4" Cap*

description of formations encountered	from	to
<i>Brown Clay</i>	<i>0</i>	<i>20</i>
<i>Brown Clay part Sand</i>	<i>20</i>	<i>40</i>
<i>Red Sand</i>	<i>40</i>	<i>60</i>
<i>White Sand</i>	<i>60</i>	<i>110</i>
<i>White Clay</i>	<i>110</i>	<i>130</i>
<i>White Sand</i>	<i>130</i>	<i>154</i>

DRILLERS REMARKS:


DEPT. OF NATURAL RESOURCES
 BUREAU OF LAND & WATER RESOURCES

MAY 24 1982

RECEIVED

If well telescopes please sketch and show depths.

GROUND LEVEL

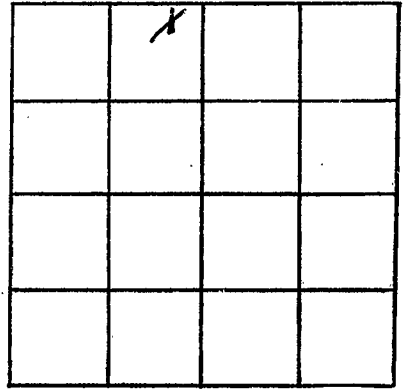

SECTION 18

Please indicate well location X.

ADDITIONAL INFORMATION

If more than one screen,
show locations of each on sketch.