

Marshall
J
2072

MISSISSIPPI
BOARD OF WATER COMMISSIONERS
416 North State Street
Jackson, Mississippi 39201

WATER WELL DRILLERS LOG

May 13 1982 Earl Jones Well Co Marshall
date well completed firm name county well located


LANDOWNER:	description of formations encountered	from	to
George Waldo	Topsoil + clay	0	15
Byholia Miss. Pt. (mailing address)	sand	15	28
WELL LOCATION:	clay	28	35
sec 5 T 3 N R 4 E S W	sand	35	90
2 1/4 miles W of Victoria (distance) (direction) (nearest town)	clay	90	95
WELL PURPOSE: Home (home, irrigation, municipal, industrial)	sand	95	135
WELL COMPLETION DATA:			
(1) diameter (inches) 4"			
(2) total depth (feet) 135			
(3) static water level (feet) 100 below top of ground.			
(4) casing Plastic 125 (material) (depth)			
4" if telescope see back. (size)			
(5) screen 10' 125 (length) (depth to top)			
4" - 013 Plastic (size) (material)			
(6) pump 1/2 14 (HP) (yield gpm)			
electric (type power)			
(7) electric log no (yes or no)			
(organization running log)			
(8) how well bottom plugged Plastic cap			
DRILLERS REMARKS:			

DEPT. OF NATURAL RESOURCES
BUREAU OF LAND & WATER RESOURCES

MAY 19 1982
RECEIVED

If well telescopes please sketch and show depths.

GROUND LEVEL

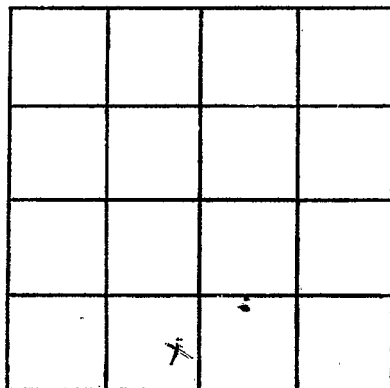

SECTION 5

Please indicate well location X.

ADDITIONAL INFORMATION

If more than one screen,
show locations of each on sketch.