

**MISSISSIPPI DEPARTMENT OF NATURAL RESOURCES**  
**Bureau of Land and Water Resources**  
 Southport Mall  
 P.O. Box 10631  
 Jackson, Mississippi 39209  
**WATER WELL DRILLERS LOG**

Marshall  
J 2073

5-20-82 19 82  
 date well completed

**HICKS WELL COMPANY**

1 - BOX #/ name

Marshall  
 county well located

LANDOWNER: Roosevelt York  
PO Box 135  
Victoria, MS  
 (mailing address)

Description of formations encountered	from to	
Red Clay	0	10
Red Sand & Gravel	10	80
White Clay	80	125
White Sand	125	170

WELL LOCATION:  
 sec. 28 T-3 N R-4 E  
3 1/2 miles E of Watson  
 (distance) (direction) (nearest town)

WELL PURPOSE: HOME  
 (home, irrigation, municipal, industrial)

- WELL COMPLETION DATA:
- (1) diameter (inches) 4
  - (2) total depth (feet) 170
  - (3) static water level (feet) 110 below above top of ground.
  - (4) casing PVC, 170,  
 (material) (depth)  
         If telescope see back.  
 (size)
  - (5) screen 10ft, 160  
 (length) (depth to top)  
0.10, PVC,  
 (size) (material)
  - (6) pump 1/2 10  
 (HP) (yield gpm)  
220V  
 (type power)
  - (7) electric log No  
 (yes or no)  
          
 (organization running log)
  - (8) how well bottom plugged Cap

DRILLERS REMARKS:


DEPT. OF NATURAL RESOURCES  
 BUREAU OF LAND & WATER RESOURCES

JUN 14 1982

**RECEIVED**

If well telescopes please sketch and show depths.

GROUND LEVEL

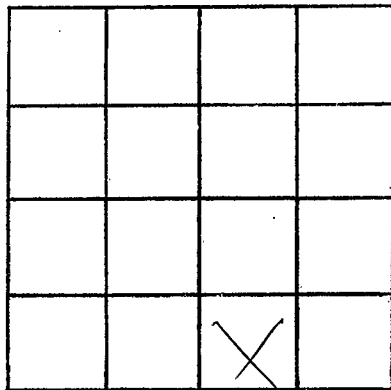

SECTION 20

Please indicate well location X.

ADDITIONAL INFORMATION

If more than one screen,  
show locations of each on sketch.