

Marshall
8 2077

MISSISSIPPI
 BOARD OF WATER COMMISSIONERS
 416 North State Street
 Jackson, Mississippi 39201

WATER WELL DRILLERS LOG

Dec 10 1982 Earl Jones Well Co Marshall
 date well completed firm name county well located

LANDOWNER:
Marshall Co Community Center
Victoria Miss
 (mailing address)

description of formations encountered	from	to
<u>Topsoil + clay</u>	<u>0</u>	<u>14</u>
<u>Sand</u>	<u>14</u>	<u>40</u>
<u>Clay</u>	<u>40</u>	<u>95</u>
<u>Sand</u>	<u>95</u>	<u>100</u>
<u>clay</u>	<u>100</u>	<u>110</u>
<u>Sand</u>	<u>110</u>	<u>140</u>

WELL LOCATION:
 sec 9 T 3 N R 4 E
 S W
1/8 miles 2 of Victoria
 (distance) (direction) (nearest town)

WELL PURPOSE: Community Center
 (home, irrigation, municipal, industrial)

- WELL COMPLETION DATA:
- (1) diameter (inches) 4"
 - (2) total depth (feet) 140
 - (3) static water level (feet) 55 below top of ground.
 - (4) casing plastic, 130
 (material) (depth)
4" If telescope see back.
 (size)
 - (5) screen 10', 130
 (length) (depth to top)
Ø 13 - 4", plastic
 (size) (material)
 - (6) pump 1/2, 14
 (HP) (yield gpm)
electric
 (type power)
 - (7) electric log no
 (yes or no)
- (organization running log)
- (8) how well bottom plugged plastic cap

DRILLERS REMARKS:


DEPT. OF NATURAL RESOURCES
 BUREAU OF LAND & WATER RESOURCES

DEC 15 1982

RECEIVED

If well telescopes please sketch and show depths.

GROUND LEVEL

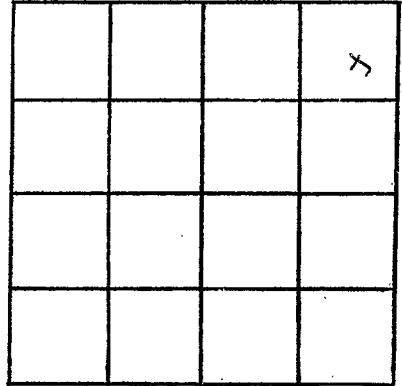

SECTION 9

Please indicate well location X.

ADDITIONAL INFORMATION

If more than one screen,
show locations of each on sketch.