

MISSISSIPPI DEPARTMENT OF NATURAL RESOURCES
Bureau of Land and Water Resources
 Southport Mall
 P.O. Box 10631
 Jackson, Mississippi 39209
WATER WELL DRILLERS LOG

Marshall
 of 2080

3-10 1983 Gullett Well Drilling Marshall
 date well completed firm name county well located

LANDOWNER: *Toni Fuller*
 Holly Springs, Ms
 (mailing address)
 WELL LOCATION:
 sec. 13 T-3 N, R-4 E
0 miles in of Red Bank
 (distance) (direction) (nearest town)

description of formations encountered	from	to
<i>Top soil</i>	<i>0</i>	<i>2 1/2'</i>
<i>Red clay</i>	<i>3'</i>	<i>30'</i>
<i>Sand and clay</i>	<i>30</i>	<i>225</i>

WELL PURPOSE: Home
 (home, irrigation, municipal, industrial)

- WELL COMPLETION DATA:
- (1) diameter (inches) 4"
 - (2) total depth (feet) 235'
 - (3) static water level (feet) 180' below above top of ground.
 - (4) casing 1160 PVC, 225'
 (material) (depth)
4" if telescope see back.
 (size)
 - (5) screen 10', 225'
 (length) (depth to top)
4", 1160 PVC
 (size) (material)
 - (6) pump 3/4, 10
 (HP) (yield gpm)
electric
 (type power)
 - (7) electric log NO
 (yes or no)
 (organization running log)
 - (8) how well bottom plugged Cap

DEPT. OF NATURAL RESOURCES
 BUREAU OF LAND & WATER RESOURCES


JUN 21 1983

RECEIVED

DRILLERS REMARKS:

If well telescopes please
sketch and show depths.

GROUND LEVEL

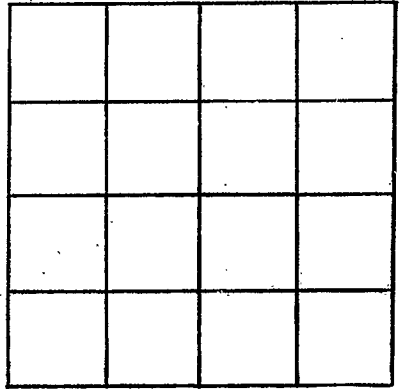

SECTION _____

Please indicate well location X.

ADDITIONAL INFORMATION

If more than one screen,
show locations of each on sketch.