

Marshall
2081

MISSISSIPPI DEPARTMENT OF NATURAL RESOURCES
Bureau of Land and Water Resources
Southport Mall
P.O. Box 10631
Jackson, Mississippi 39209
WATER WELL DRILLERS LOG

9-7 19 83
date well completed

HICKS WELL CO.
RL firm name 131
Saratoga MS 39268

Marshall
county well located

LANDOWNER: <i>South Victoria Water</i>	Description of formations encountered	from	to
<i>Gen. & Del.</i>			
<i>Victoria, Miss.</i> (mailing address)	Red clay	0	10
WELL LOCATION: sec. <u>9</u> T <u>3</u> N R <u>4</u> E <u>1/2</u> miles <u>SW</u> of <u>Victoria</u> (distance) (direction) (nearest town)	Red sand	10	50
WELL PURPOSE: <i>Subdivision</i> (home, irrigation, municipal, industrial)	White sand	50	120
WELL COMPLETION DATA:			
(1) diameter (inches) <u>4</u>			
(2) total depth (feet) <u>170</u>			
(3) static water level (feet) <u>70</u> ^{below} / _{above} top of ground.			
(4) casing <u>PVC</u> , <u>170</u> , (material) (depth) <u>4</u> " (size) If telescope see back.			
(5) screen <u>10'</u> , <u>160'</u> (length) (depth to top)			
<u>1013</u> , <u>PVC</u> (size) (material)			
(6) pump <u>1</u> , <u>18</u> (HP) (yield gpm)			
<u>2200</u> (type power)			
(7) electric log <u>No</u> (yes or no)			
(organization running log)			
(8) how well bottom plugged <u>Cap</u>			
DRILLERS REMARKS:			


DEPT. OF NATURAL RESOURCES
BUREAU OF LAND & WATER RESOURCES

SEP 25 1983

RECEIVED

If well telescopes please sketch and show depths.

GROUND LEVEL

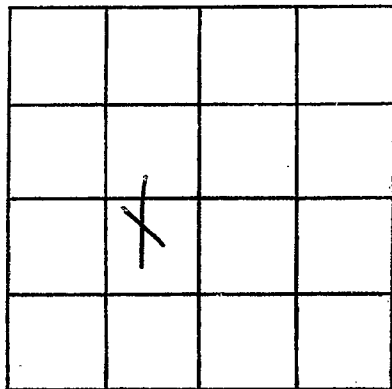

SECTION 9

Please indicate well location X.

ADDITIONAL INFORMATION

If more than one screen, show locations of each on sketch.