

MISSISSIPPI DEPARTMENT OF NATURAL RESOURCES
Bureau of Land and Water Resources
 Southport Mall
 P.O. Box 10631
 Jackson, Mississippi 39209
WATER WELL DRILLERS LOG

Marshall
J 2082

9-8 1983
 date well completed

HICKS WELL CO.
 Dr. 1 Dr. 2
 Senatobia, MS 38668

Marshall
 county well located

LANDOWNER: Alma Victoria Water
Ann. Del.
Victoria, Miss.
 (mailing address)

description of formations encountered	from to	
<u>Red clay</u>	<u>0</u>	<u>10</u>
<u>Red sand</u>	<u>10</u>	<u>50</u>
<u>White sand</u>	<u>50</u>	<u>145</u>

WELL LOCATION:
 sec. 9 T. 3 N R. 4 E
W
1/2 miles SW of Victoria
 (distance) (direction) (nearest town)

WELL PURPOSE: Subsidence
 (home, irrigation, municipal, industrial)

- WELL COMPLETION DATA:
- (1) diameter (inches) 4
 - (2) total depth (feet) 145
 - (3) static water level (feet) 70 ^{below} _{above} top of ground.
 - (4) casing PVC 145
 (material) (depth)
4"
 (size) If telescope see back.
 - (5) screen 20' 135'
 (length) (depth to top)
013 PVC
 (size) (material)
 - (6) pump 1 18
 (HP) (yield gpm)
220V
 (type power)
 - (7) electric log no
 (yes or no)
 - (organization running log)
 - (8) how well bottom plugged Cap

DRILLERS REMARKS:


DEPT. OF NATURAL RESOURCES
 BUREAU OF LAND & WATER RESOURCES

SEP 22 1983

RECEIVED

If well telescopes please sketch and show depths.

GROUND LEVEL

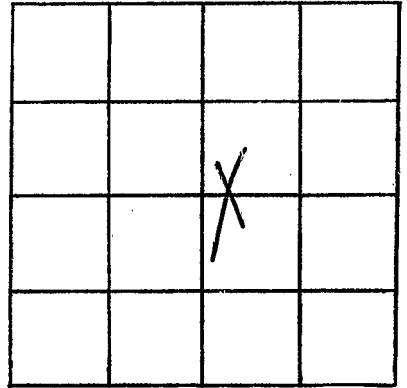

SECTION 9

Please indicate well location X.

ADDITIONAL INFORMATION

If more than one screen
show locations of each on sketch.