

MISSISSIPPI DEPARTMENT OF NATURAL RESOURCES

Bureau of Land and Water Resources

Southport Mall

P.O. Box 10631

Jackson, Mississippi 39209

WATER WELL DRILLERS LOG

Marshall  
7 2083

3/2/84 19 gullett well drilling  
date well completed

firm name

Marshall  
county well located

LANDOWNER: Wynne Ballard

description of formations encountered

from to

Byholia

Top Soil

0 2

(mailing address)

Red Clay

2 2.5

WELL LOCATION:

sec. 1 T 3 N R 4 E  
3 miles East of Wadsworth  
(distance) (direction) (nearest town)

Clay and sand

2.5 80

limestone

80 130

WELL PURPOSE:

(home, irrigation, municipal, industrial)

WELL COMPLETION DATA:

- (1) diameter (inches) 4"
- (2) total depth (feet) 130'
- (3) static water level (feet) 80 below above top of ground.
- (4) casing PVC 120'  
(material) (depth)  
(size) If telescope see back.
- (5) screen 10 130/20  
(length) (depth to top)  
(size) PVC (material)
- (6) pump 1/2 10  
(HP) (yield gpm)  
float  
(type power)
- (7) electric log no  
(yes or no)  
(organization running log)
- (8) how well bottom plugged Cap

DEPT. OF NATURAL RESOURCES  
BUREAU OF LAND & WATER RESOURCES


APR 26 1984

RECEIVED

DRILLERS REMARKS:

If well telescopes please sketch and show depths.

GROUND LEVEL

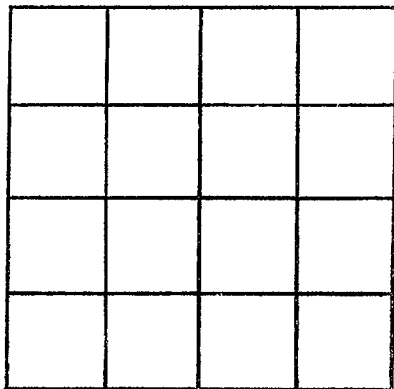

SECTION \_\_\_\_\_

Please indicate well location X.

ADDITIONAL INFORMATION

If more than one screen, show locations of each on sketch.