

MISSISSIPPI DEPARTMENT OF NATURAL RESOURCES

Bureau of Land and Water Resources

Southport Mall

P.O. Box 10631

Jackson, Mississippi 39209

WATER WELL DRILLERS LOG

Marshall
J 2085
5-22-85

5-22-1985
date well completed

HICKS WELL CO.
firm name

Marshall
county well located

LANDOWNER: David Cummings

description of formations encountered

from to

P.O. Box 196

Victoria Ms 38879
(mailing address)

Red Clay	0	10
Red Sand	10	60
White Sand & clay	60	80
White Sand	80	140

WELL LOCATION:

sec. 9 T-3 N R-4 E
S W
miles of Victoria
(distance) (direction) (nearest town)

WELL PURPOSE: Home
(home, irrigation, municipal, industrial)

WELL COMPLETION DATA:

- (1) diameter (inches) 4"
- (2) total depth (feet) 140'
- (3) static water level (feet) 90' below top of ground.
- (4) casing PVC, 130' (depth), 4" (size) if telescope see back.
- (5) screen 10' (length), 130' (depth to top), #10 (size), PVC (material)
- (6) pump 3/4 (HP), 10 (yield gpm), 220 Electric (type power)
- (7) electric log NO (yes or no)
- (8) how well bottom plugged Cap


RECEIVED
JUL 1 - 1985

DRILLERS REMARKS:

Department of Natural Resources
Bureau of Land & Water Resources

If well telescopes please sketch and show depths.

GROUND LEVEL

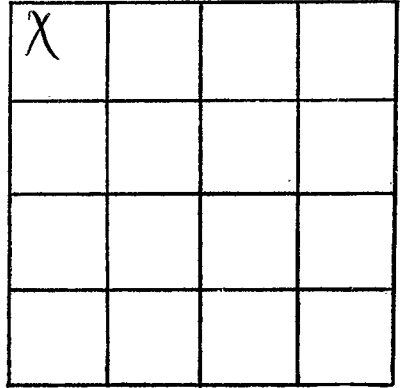

SECTION 9

Please indicate well location X.

ADDITIONAL INFORMATION

If more than one screen, show locations of each on sketch.