

MISSISSIPPI DEPARTMENT OF NATURAL RESOURCES

Bureau of Land and Water Resources

Southport Mall

P.O. Box 10631

Jackson, Mississippi 39209

WATER WELL DRILLERS LOG

J 2087
Marshall
1-29-85

#4669

1-29 1985 Garner Host Well Co. Marshall
date well completed firm name county well located

LANDOWNER: Richard Warden

Rt 4 Box 667

Byhalia, Miss. 38611
(mailing address)

WELL LOCATION:

sec. 7 T-3 N R-4 E
1 1/2 miles E of Warden
(distance) (direction) (nearest town)

WELL PURPOSE:

(home) Irrigation, municipal, industrial

WELL COMPLETION DATA:

- (1) diameter (inches) 4
- (2) total depth (feet) 115
- (3) static water level (feet) 80 below above top of ground.
- (4) casing plastic, 105, (material) (depth)
if telescope see back.
(size)
- (5) screen 10, 105 (length) (depth to top)
4, Plastic (size) (material)
- (6) pump 3/4, 10 (HP) (yield gpm)
electric (type power)
- (7) electric log (yes or no)

(organization running log)

(8) how well bottom plugged 4" Plastic cap

description of formations encountered

from

to

Brown Clay	0	15
Red Sand	15	60
White Clay	60	80
White Sand	80	115


DRILLERS REMARKS:

RECEIVED
SEP 30 1985

Department of Natural Resources
Bureau of Land & Water Resources

If well telescopes please sketch and show depths.

GROUND LEVEL

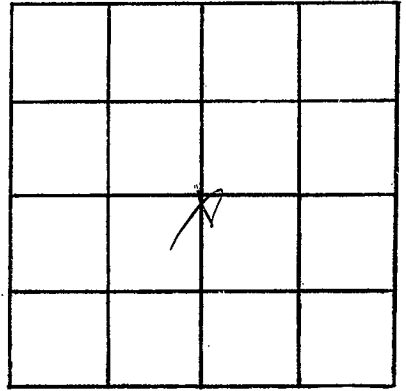

SECTION 7

Please indicate well location X.

ADDITIONAL INFORMATION

If more than one screen, show locations of each on sketch.