

MISSISSIPPI DEPARTMENT OF NATURAL RESOURCES

Bureau of Land and Water Resources

Southport Mall

P.O. Box 10631

Jackson, Mississippi 39209

WATER WELL DRILLERS LOG

Marshall  
J 2089

date well completed 10-16-95

HICKS WELL COMPANY

RT. 1 - BOX 157

Marshall  
county well located

LANDOWNER: Senators

| description of formations encountered | from      | to         |
|---------------------------------------|-----------|------------|
|                                       |           |            |
| <u>Red clay</u>                       | <u>0</u>  | <u>10</u>  |
| <u>Red sand</u>                       | <u>10</u> | <u>30</u>  |
| <u>White sand</u>                     | <u>30</u> | <u>140</u> |

Lot # 4 Box 603

Bylonia, MS 38611  
(mailing address)

WELL LOCATION:

sec. 9 T 3 N R 4 E  
S W  
1 miles S of Victoria  
(distance) (direction) (nearest town)

WELL PURPOSE: Home  
(home, irrigation, municipal, industrial)

WELL COMPLETION DATA:

- (1) diameter (inches) 4" x 7"
- (2) total depth (feet) 140
- (3) static water level (feet) 220' <sup>below</sup> above top of ground.
- (4) casing PVC, 125'  
(material) (depth)  
4"  
(size) if telescope see back.
- (5) screen 15', 125'  
(length) (depth to top)  
2", PVC  
(size) (material)
- (6) pump 1hp, 18  
(HP) (yield gpm)  
220W  
(type power)
- (7) electric log NO  
(yes or no)  
  
(organization running log)
- (8) how well bottom plugged Cap


RECEIVED  
DEC 1 0 1995

DEPARTMENT of Natural Resources  
BUREAU of Land & Water

DRILLERS REMARKS: From 125' - 140', there is a 2" screen

If well telescopes please sketch and show depths.

GROUND LEVEL

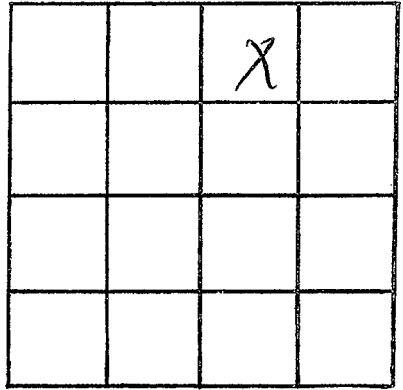

SECTION 9

Please indicate well location X.

ADDITIONAL INFORMATION

If more than one screen; show locations of each on sketch.