

MISSISSIPPI DEPARTMENT OF NATURAL RESOURCES

Bureau of Land and Water Resources

Southport Mall

P.O. Box 10631

Jackson, Mississippi 39209

WATER WELL DRILLERS LOG

HICKS WELL COMPANY

Marshall

Marshall  
J  
2090

10-17 1985  
date well completed

RT. firm name: BOX 157  
SENATOBIA, MISS.

county well located

LANDOWNER: Virgil Bunting

description of formations encountered

from to

Rt #4 Box 598

Red clay

0 10

Byhalia, MS 38611  
(mailing address)

Red sand

10 30

WELL LOCATION:

sec. 9 T-3 N R-4 E  
S W

white sand

30 145

1 miles S of Vicksburg  
(distance) (direction) (nearest town)

WELL PURPOSE: Home  
(home, irrigation, municipal, industrial)

WELL COMPLETION DATA:

- (1) diameter (inches) 4"
- (2) total depth (feet) 145'
- (3) static water level (feet) 120' below top of ground.
- (4) casing PVC, 135' (depth)  
4" (size) if telescope see back.
- (5) screen 10' (length), 135' (depth to top)  
.013 (size), PVC (material)
- (6) pump 1/2 (HP), 10 (yield gpm)  
2200 (type power)
- (7) electric log NO (yes or no)  
(organization running log)
- (8) how well bottom plugged Cap


RECEIVED  
DEC 18 1985

Department of Natural Resources  
Bureau of Land & Water Resources

DRILLERS REMARKS:

If well telescopes please  
sketch and show depths.

GROUND LEVEL

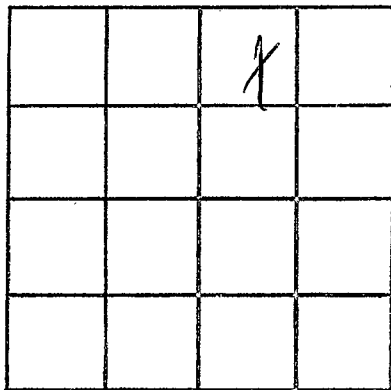

SECTION 9

Please indicate well location X.

ADDITIONAL INFORMATION

If more than one screen,  
show locations of each on sketch.