

MISSISSIPPI DEPARTMENT OF NATURAL RESOURCES

Bureau of Land and Water Resources

Southport Mall

P.O. Box 10631

Jackson, Mississippi 39209

WATER WELL DRILLERS LOG

HICKS WELL COMPANY

Rt. 1 BOX 157
SENATORIA, MISS.

Marshall county well located

Marshall
J
2091

11-2 1985
date well completed

LANDOWNER: Jessie Rowlin

description of formations encountered

from

to

Rt # 4 Box 44

Red clay

0 20

Byhalia, MS 38611
(mailing address)

Red sand

20 30

WELL LOCATION:

sec. 29 T. 3 N. R. 4 E
S W
3 miles E of Watson
(distance) (direction) (nearest town)

white clay

30 155

white sand

155 185

WELL PURPOSE:

Home
(home, irrigation, municipal, industrial)

WELL COMPLETION DATA:

- (1) diameter (inches) 4"
- (2) total depth (feet) 185'
- (3) static water level (feet) 40' below top of ground.
- (4) casing (material) PVC (depth) 175'
4" (size) if telescope see back.
- (5) screen (length) 10' (depth to top) 175'
013 (size) PVC (material)
- (6) pump (HP) 3/4 (yield gpm) 10
- 22011 (type power)
- (7) electric log (yes or no) No

(organization running log)

(8) how well bottom plugged Cap

DRILLERS REMARKS:


RECEIVED

DEC 18 1985

Department of Natural Resources
Bureau of Land & Water Resources

If well telescopes please sketch and show depths.

GROUND LEVEL

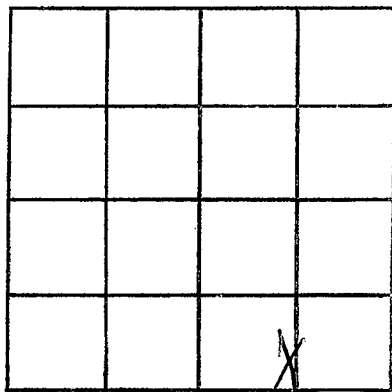

SECTION 29

Please indicate well location X.

ADDITIONAL INFORMATION

If more than one screen,
show locations of each on sketch.