

MISSISSIPPI DEPARTMENT OF NATURAL RESOURCES

Bureau of Land and Water Resources

Southport Mall

P.O. Box 10631

Jackson, Mississippi 39209

WATER WELL DRILLERS LOG

MARSHALL  
25 2093

9-15-1985 date well completed  
85 Long Carpenter Wells firm name  
Marshall county well located

LANDOWNER: Richard Patterson

Red Bonny, Ms.  
RFD  
(mailing address)


WELL LOCATION:  
sec. 24-3 T. 3 N. R. 4 E. W.  
1 miles South of Red Bonny  
(distance) (direction) (nearest town)

WELL PURPOSE: Home  
(home, irrigation, municipal, industrial)

WELL COMPLETION DATA:

- (1) diameter (inches) 4
- (2) total depth (feet) 142
- (3) static water level (feet) 105 below above top of ground.
- (4) casing PVC, 132'  
(material) (depth)  
(size) if telescope see back.
- (5) screen 10', 132'  
(length) (depth to top)  
4 in., PVC  
(size) (material)
- (6) pump 3/4, 12  
(HP) (yield gpm)  
Electric  
(type power)
- (7) electric log No.  
(yes or no)  
(organization running log)
- (8) how well bottom plugged PVC cap

description of formations encountered	from	to
<u>Surface Soil</u>	<u>0</u>	<u>18</u>
<u>Med. &amp; Fine Red Sand</u>	<u>18</u>	<u>45</u>
<u>Med White Sand</u>	<u>45</u>	<u>70</u>
<u>White Clay</u>	<u>70</u>	<u>98</u>
<u>White coarse Sand</u>	<u>98</u>	<u>142</u>

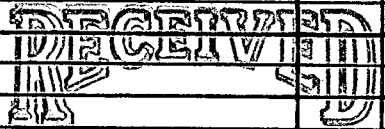


JUL 23 1986

Department of Natural Resources  
Bureau of Land & Water Resources

DRILLERS REMARKS:

If well telescopes please sketch and show depths.

GROUND LEVEL

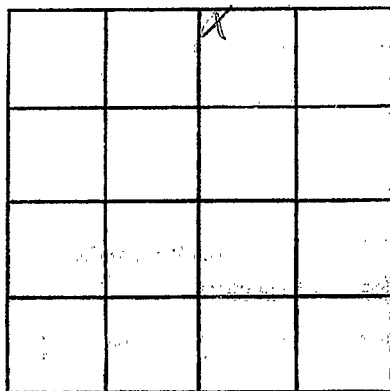

SECTION 24

Please indicate well location X.

ADDITIONAL INFORMATION

If more than one screen, show locations of each on sketch.