

MISSISSIPPI DEPARTMENT OF NATURAL RESOURCES

Bureau of Land and Water Resources

Southport Mall

P.O. Box 10631

Jackson, Mississippi 39209

WATER WELL DRILLERS LOG

MARSHAN
J 2094

11-15 1985 Larry Carpenter Wells Marshall
date well completed firm name county well located

LANDOWNER: Agrippa Crose
Byrdline, Mo
R. F. D.
(mailing address)

description of formations encountered	from	to
<u>Surface Soil</u>	<u>0</u>	<u>25</u>
<u>Med. Red Sand</u>	<u>25</u>	<u>60</u>
<u>Med. Coarse White Sand</u>	<u>60</u>	<u>104</u>
<u>White Clay</u>	<u>104</u>	<u>120</u>
<u>White Coarse Sand</u>	<u>120</u>	<u>180</u>

WELL LOCATION:
sec. 28 T. 3 N. R. 4 E.
S. W.
4 miles South of Victoria
(distance) (direction) (nearest town)

WELL PURPOSE: Home
(home, irrigation, municipal, industrial)

- WELL COMPLETION DATA:
- (1) diameter (inches) 4
 - (2) total depth (feet) 180
 - (3) static water level (feet) 115 below above top of ground.
 - (4) casing PVC, 170',
(material) (depth)
(size) if telescope see back.
 - (5) screen 10', 170'
(length) (depth to top)
4", PVC
(size) (material)
 - (6) pump 3/4, 12
(HP) (yield gpm)
2 hp.
(type power)
 - (7) electric log no
(yes or no)
(organization running log)
 - (8) how well bottom plugged Pvc Cap


RECEIVED
JUL 23 1986

Department of Natural Resources
Bureau of Land and Water Resources

DRILLERS REMARKS:

If well telescopes please sketch and show depths.

GROUND LEVEL

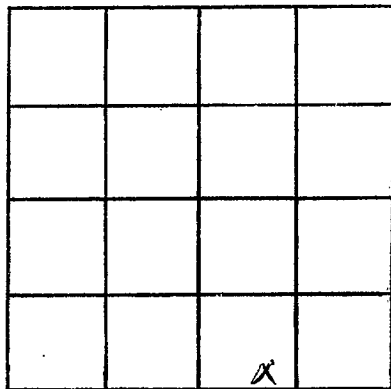

SECTION 28

Please indicate well location X.

ADDITIONAL INFORMATION

If more than one screen, show locations of each on sketch.