

MISSISSIPPI DEPARTMENT OF NATURAL RESOURCES

Bureau of Land and Water Resources

Southport Mall

P.O. Box 10631

Jackson, Mississippi 39209

WATER WELL DRILLERS LOG

MARSHALL  
J 2095

7-31 1986 86 Sweet Water Well Marshall  
date well completed firm name county well located

LANDOWNER: James S. Taylor  
Rt 3 Box 275  
Bryalia, Mo  
(mailing address)

description of formations encountered	from	to
<u>Top soil</u>	<u>0'</u>	<u>2'</u>
<u>Red sand clay</u>	<u>2'</u>	<u>15'</u>
<u>White sand clay</u>	<u>15'</u>	<u>100'</u>
<u>White sand</u>	<u>100'</u>	<u>140'</u>

WELL LOCATION:

sec. 9 T. 3 N. R. 4 E  
(S) (W)  
0 miles of Victoria  
(distance) (direction) (nearest town)

WELL PURPOSE: HOME  
(home, irrigation, municipal, industrial)

WELL COMPLETION DATA:

- (1) diameter (inches) 4"
- (2) total depth (feet) 140'
- (3) static water level (feet) 85' below top of ground.
- (4) casing PRC, 130'  
(material) (depth)  
4" if telescope see back.  
(size)
- (5) screen 10', 130'  
(length) (depth to top)  
4", PRC  
(size) (material)
- (6) pump 1/2, 10  
(HP) (yield gpm)  
Elec  
(type power)
- (7) electric log No  
(yes or no)

(organization running log)

(8) how well bottom plugged Cap


10631  
AUG 11 1986

Department of Natural Resources  
Bureau of Land & Water Resources

DRILLERS REMARKS:

If well telescopes please sketch and show depths.

GROUND LEVEL

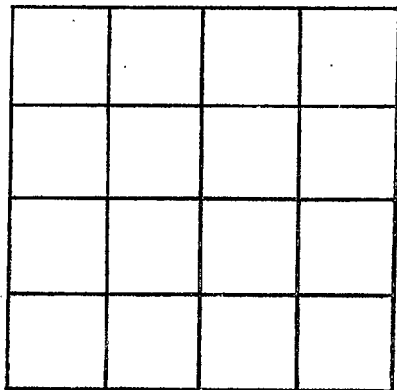

SECTION \_\_\_\_\_

Please indicate well location X.

ADDITIONAL INFORMATION

If more than one screen,  
show locations of each on sketch.