

MISSISSIPPI DEPARTMENT OF NATURAL RESOURCES

Bureau of Land and Water Resources

P.O. Box 10631

Jackson, Mississippi 39209

WATER WELL DRILLERS LOG

COUNTY WELL LOCATED MARSHAL	
WELL NUMBER J 2097	CODED
DATE WELL COMPLETED 9-3-84	

PERMIT NUMBER
NAME OF DRILLING FIRM Hicks Well Co
Senobia, MS

NAME & MAILING ADDRESS OF LANDOWNER SAMUEL HILL			
RT. 3 BOX 360-AS			
WELL LOCATION:	SEC	TOWNSHIP	RANGE
1/2	13	3	N 4 E
DISTANCE	DIRECTION	NEAREST TOWN	
1/2 Miles	S	of Red BANK	
OTHER LANDMARK			
WELL PURPOSE: Home, Irrigation, Municipal, Industrial, Fish Pond, etc.			

PUMP DATA		
PUMP TYPE (Circle One): <input checked="" type="checkbox"/> Submersible, Turbine, Jet, Flowing Well, Other (Describe) _____		
POWER TYPE (Circle One): Electric, Tractor, Diesel, Gasoline, Butane, Other (Describe) _____		
Pump Capacity (GPM)	No. of Stages	Setting Depth
10	7	160 FT.
PUMP TEST		
Well yielded 10 GPM with a drawdown of _____ ft. after _____ hours of pumping		


WELL DATA		
Well Depth 183	Casing Diameter (In.) 4"	Casing Length (Ft.) 173
Type of Casing PVC	Hole Depth 183	Depth to Static Water Level 130
TYPE OF COMPLETION: (Circle One or More): <input checked="" type="checkbox"/> Gravel Packed, Underreamed, Telescoped, Natural Development, Open Hole, Other (Describe) _____		
Top of Lap Pipe or Reduction in Casing		
FEET	IF TELESCOPED OR MORE THAN ONE SCREEN: USE BACK PAGE	

LOG DATA	
TYPE OF LOG RUN (Circle One): No Log Run, Electric, Gamma Ray, Density, Sonic, Neutron, Other (Describe) _____	
Name of Organization Running Log	

SCREEN DATA		
Diameter - Inches 4"	Length - Feet 10	Slot Size - Inches 0.13
Screen Type PVC Slotted	Depth to Bottom - Feet 10	

GEOLOGIC DATA (Office Use Only)			
Surface Elev.	Geologic Unit	Unit Thickness	Depth to Top
Subs. SWL	Date	Analysis	Aquifer Test
Driller's Remarks			

DESCRIPTION OF FORMATIONS ENCOUNTERED	FROM	TO
R.C.	0	10
W.C.	10	30
P.S.	30	60
A.C.	60	130
B.C.	130	160
W.S.	160	183

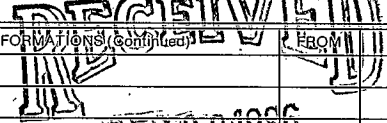


SEP 08 1986

Department of Natural Resources
Bureau of Land & Water Resources

IF MORE SPACE IS NEEDED, USE BACK

If well telescopes please sketch and show depths.

GROUND LEVEL

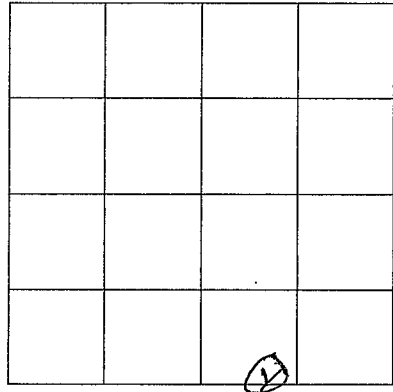

SECTION _____

Please indicate well location X.

ADDITIONAL INFORMATION

If more than one screen,
show location of each on sketch.