

MISSISSIPPI DEPARTMENT OF NATURAL RESOURCES

Bureau of Land and Water Resources

P.O. Box 10631

Jackson, Mississippi 39209

WATER WELL DRILLERS LOG

COUNTY WELL LOCATED
Marshall

WELL NUMBER
52102

CODED

DATE WELL COMPLETED
7-1-87

PERMIT NUMBER

NAME OF DRILLING FIRM
HICKS WELL COMPANY

RT. 1 BOX 157

NAME & MAILING ADDRESS OF LANDOWNER
Lynthia Lee

Box 1 Box 56-2

Red Bank MS 38661

WELL LOCATION: SEC *24* TOWNSHIP *3* RANGE *4*

DISTANCE *2* MILES *E* DIRECTION of *Victoria* NEAREST TOWN

OTHER LANDMARK

WELL PURPOSE: Home Irrigation, Municipal, Industrial, Fish Pond, etc.

PUMP DATA

PUMP TYPE (Circle One):
 Submersible, Turbine, Jet, Flowing Well, Other (Describe)

POWER TYPE (Circle One):
 Electric, Tractor, Diesel, Gasoline, Butane, Other (Describe)

Pump Capacity (GPM) <i>10</i>	No. of Stages <i>7</i>	Setting Depth <i>740</i> FT.
----------------------------------	---------------------------	---------------------------------

PUMP TEST

Well yielded _____ GPM with a drawdown of _____ ft. after _____ hours of pumping

WELL DATA

Well Depth <i>170</i>	Casing Diameter (In.) <i>4"</i>	Casing Length (Ft.) <i>160</i>
Type of Casing <i>Pvc</i>	Hole Depth <i>170'</i>	Depth to Static Water Level <i>120'</i>

TYPE OF COMPLETION: (Circle One or More):
Gravel Packed, Underreamed, Telescoped, (Describe) *Pvc Cap* Open Hole, Other

Top of Lap Pipe or Reduction in Casing

FEET IF TELESCOPED OR MORE THAN ONE SCREEN: USE BACK PAGE

LOG DATA

TYPE OF LOG RUN (Circle One):
 No Log Run, Electric, Gamma Ray, Density, Sonic, Neutron, Other (Describe)

Name of Organization Running Log

SCREEN DATA

Diameter - Inches <i>4"</i>	Length - Feet <i>10'</i>	Slot Size - Inches <i>013</i>
Screen Type <i>Pvc</i>		Depth to Bottom - Feet

GEOLOGIC DATA (Office Use Only)

Surface Elev.	Geologic Unit	Unit Thickness	Depth to Top
Subs. SWL	Date	Analysis	Aquifer Test

Driller's Remarks


DESCRIPTION OF FORMATIONS ENCOUNTERED	FROM	TO	FORMATIONS (Continued)	FROM	TO
<i>Red clay</i>	<i>0</i>	<i>10</i>			
<i>Red sand</i>	<i>10</i>	<i>30</i>			
<i>White sand</i>	<i>30</i>	<i>170</i>			

RECEIVED
SEP 16 1987
Department of Natural Resources
Bureau of Land & Water Resources

IF MORE SPACE IS NEEDED, USE BACK

If well telescopes please
sketch and show depths.

GROUND LEVEL

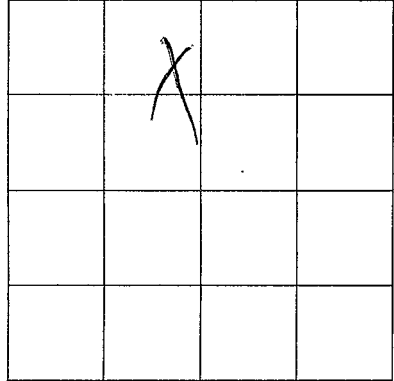

SECTION 24

Please indicate well location X.

ADDITIONAL INFORMATION

If more than one screen,
show location of each on sketch.